

* Crawford Engineering & Surveying Inc. Po Box 793 Independence IA 50644

Prepared By: Daniel T. Crawford, PLS

Crawford Engineering & Surveying, Inc., Independence, Iowa 319/334-7077

UNITED STATES PUBLIC LAND SURVEY CORNER CERTIFICATE

OF

Land Survey Monuments situated in Section 3, Township 89 N, Range 11 W, of the Fifth Principal Meridian, Black Hawk County, Iowa.


Previously recorded in N/A in County Recorder's Office.

Monument Description and Remarks:

Reason for preparing certificate: Current certificate is not on file

Evidence and detailed procedure used to establish corner position: Corner position previously established

Monumentation found or placed: Found #6 rebar 4" below road surface

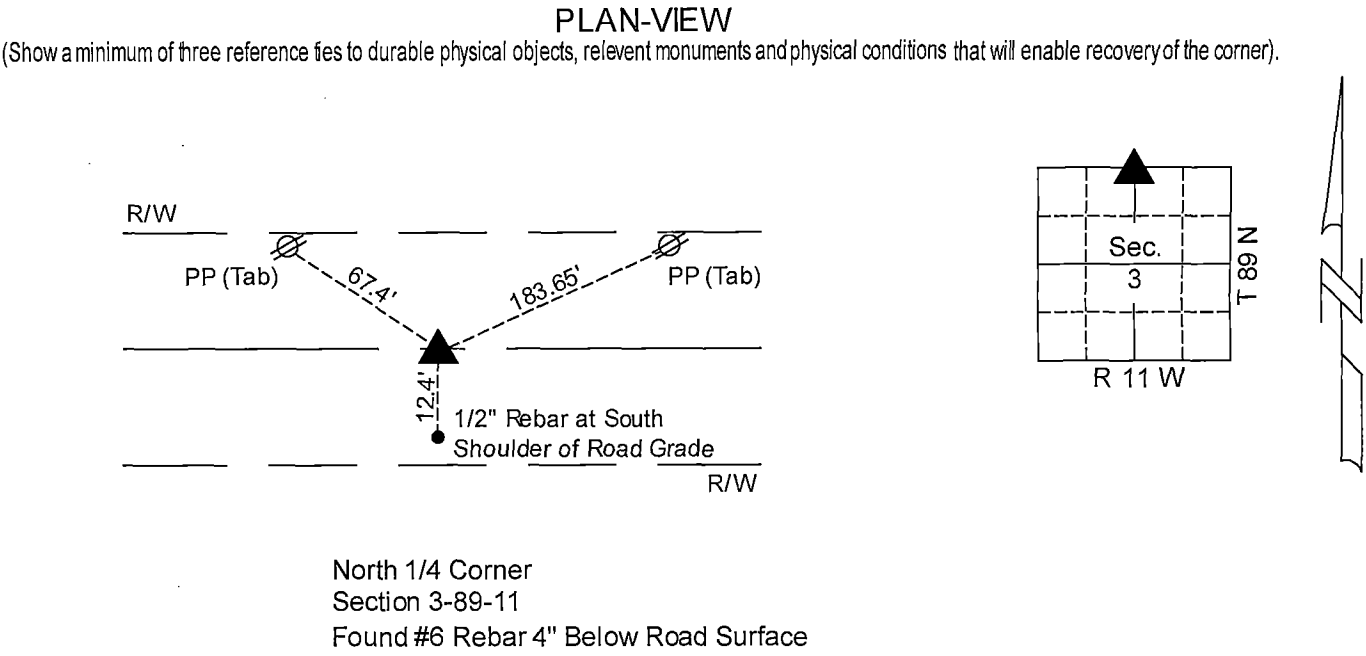

I hereby certify that the survey work was completed and this land surveying document was prepared by me or under my direct personal supervision and that I am a duly licensed professional land surveyor under the laws of the State of Iowa.

Signature: Daniel T. Crawford

DANIEL T. CRAWFORD PLS

Date: 8-14-23

Reg. No. 8812

My license renewal date is December 31, 2023

SEAL

PROFESSIONAL ENGINEER & LAND SURVEYOR

DANIEL T.

IOWA

8812

CRAWFORD

List Corners to be Indexed

Corners	Section	Twp.	Range
North 1/4 Corner	3	89 N	11 W

(7)