

SC
MISC
INDEX
MARGIN
PROOF
COMPARE

BLACK HAWK COUNTY IOWA:SS 10984
Filed for record NOV 12, 1999 at
4:00 PM. and recorded in Book 336
of MISC Page 411
Recorder
FEE 1-5.00/
PRANGE SURVEYING

PREPARED BY: PRANGE SURVEYING, 3304 PANTHER LANE, CEDAR FALLS, IOWA 50613

SLS
CERT 9-94
12-96

UNITED STATES PUBLIC LAND SURVEY CORNER CERTIFICATE OF
Land Survey Monuments situated in Section 3, Township 89 N,
Range 14 W, of the Fifth Principal Meridian, Black Hawk County, Iowa.
Previously recorded in Book —, Page —, in County Recorder's Office.

(Show reason for preparing this certificate, the evidence and detailed procedures used in establishing the corner positions and monumentation found or placed.)

Monument Description and Remarks: Found P.K. Nail in Center line
Iowa Highway #57.



RECEIVED
BLACK HAWK COUNTY
ASSESSOR

PLAN - VIEW

(Show a minimum of three reference ties to durable physical objects, relevant monuments and physical conditions that will enable recovery of the corner.)

NOT TO SCALE

1/4 COR. SEC. 3-89-14

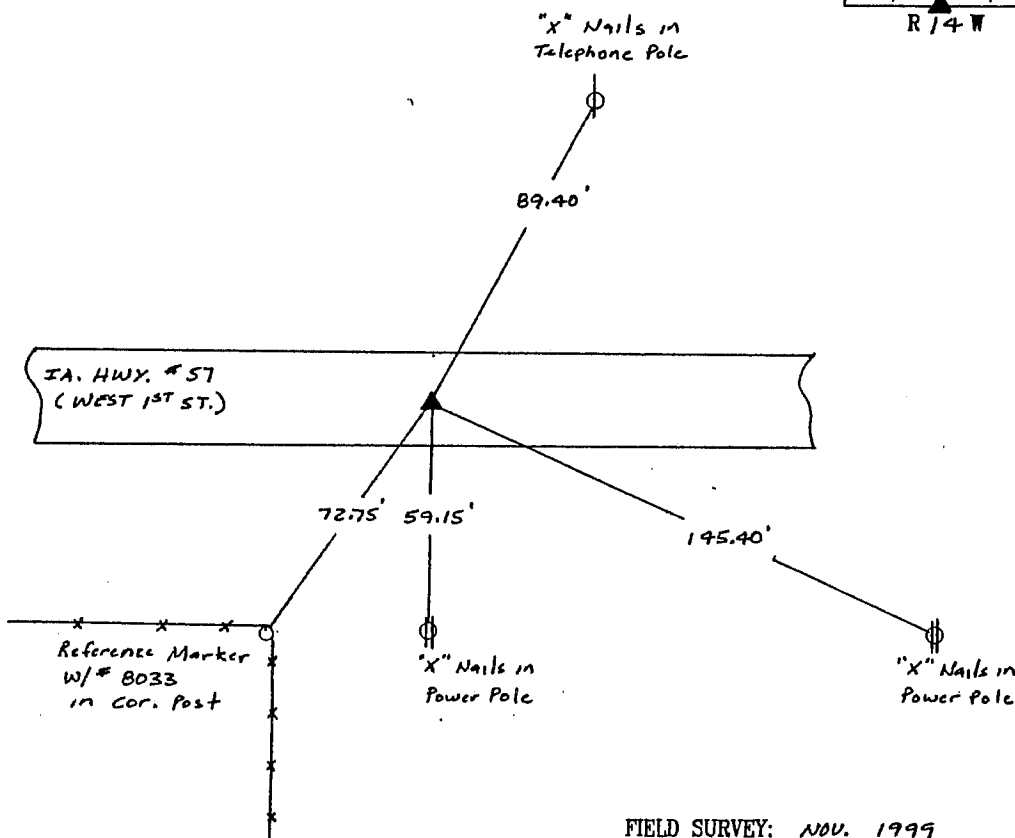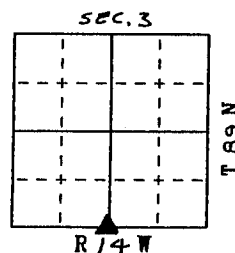

FIELD SURVEY: NOV. 1999
PREPARED BY: Dennis R. Prange

CERTIFICATION

I hereby certify that this land surveying document was prepared and the related survey work was performed by me or under my direct personal supervision and that I am a duly licensed Land Surveyor under the laws of the State of Iowa.

Dennis R. Prange NOV. 12, 1999
(date)

License Number 10040

My license renewal date is December 31, 2000

Pages or sheets covered by this seal:

This Land Corner Certificate Only.

LIST CORNERS TO BE INDEXED

Corner	Section	Township	Range
1/4 COR.	3	T89 N	R14 W

