

# UNITED STATES PUBLIC LAND SURVEY CORNER CERTIFICATE

Land Survey Monuments situated in Section 6, Township 89 North, Range 14 West, of the Fifth Principal Meridian, Black Hawk County, Iowa.


Previously recorded in N/A in County Recorder's Office.  
(book, page, document number, etc.)

(Show reason for preparing this certificate, the evidence and detailed procedures used in establishing the corner positions and monumentation found or placed.)

Monument Description and Remarks: Found 1/2" iron pin in center of East-West road in line with fence to north.

### PLAN - VIEW

(Show a minimum of three reference ties to durable physical objects, relevant monuments and physical conditions that will enable recovery of the corner)

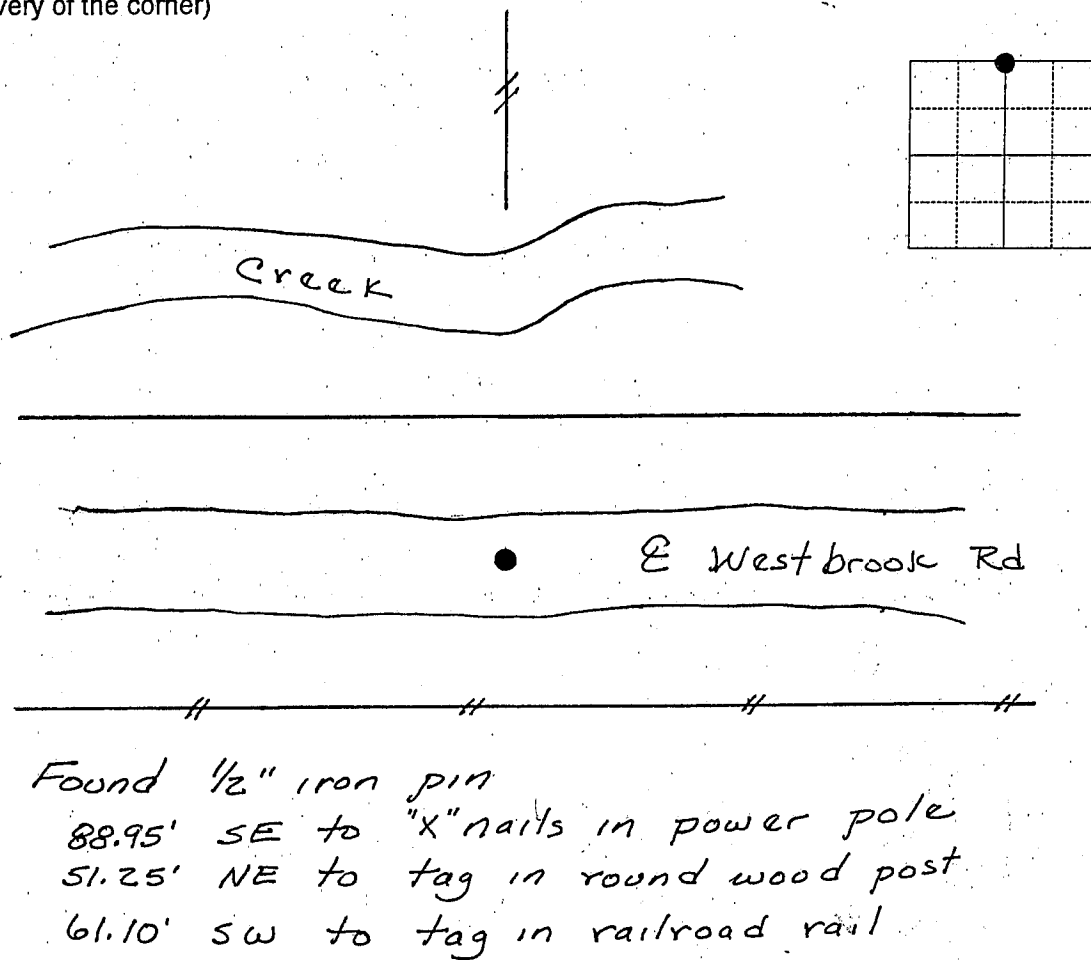

I hereby certify that the survey work was completed and this land surveying document was prepared by me or under my direct personal supervision and that I am a duly licensed land surveyor under the laws of the state of Iowa

Signature: Steve Busse  
Name typed or printed STEVE BUSSE

Date: 2/2/99 Reg. No. 9018

My license renewal date is December 31, 2000

SEAL

Corners	List Corners to be Indexed		
	Section	Twp	Range
N 1/4 COR.	6	89	14

