

UNITED STATES PUBLIC LAND SURVEY CORNER CERTIFICATE

OF

Land Survey Monuments situated in Section 10 Township 89 North, Range 14 West of the Fifth Principal Meridian, Black Hawk County, Iowa.
 Previously recorded in Book _____, Page _____.

(Show reason for preparing this certificate, the evidence and detailed procedures used in establishing the corner positions and monumentation found or placed.)



Monument Description and Remarks: Previous monument gone due to street construction 1979 survey (High Acres Add.) shows a crimped pipe marking the corner.

1991 - Remarkd corner - Found the pins marking the northwest and northeast corners of Lot 1, High Acres Add. Extended the north line of Lot 1 east 60.00' (platted dist.) and set a temp. point Found the same pin (1"Ø pipe) marking the southwest

PLAN - VIEW

(Show a minimum of three reference ties to durable physical objects, relevant monuments and physical conditions that will enable recovery of the corner.)

corner of Lot 38, Abraham 1st Add., as shown on High Acres plat. Extended the line between the pipe and the temp. point north 40.00' (platted dist.) for corner location.

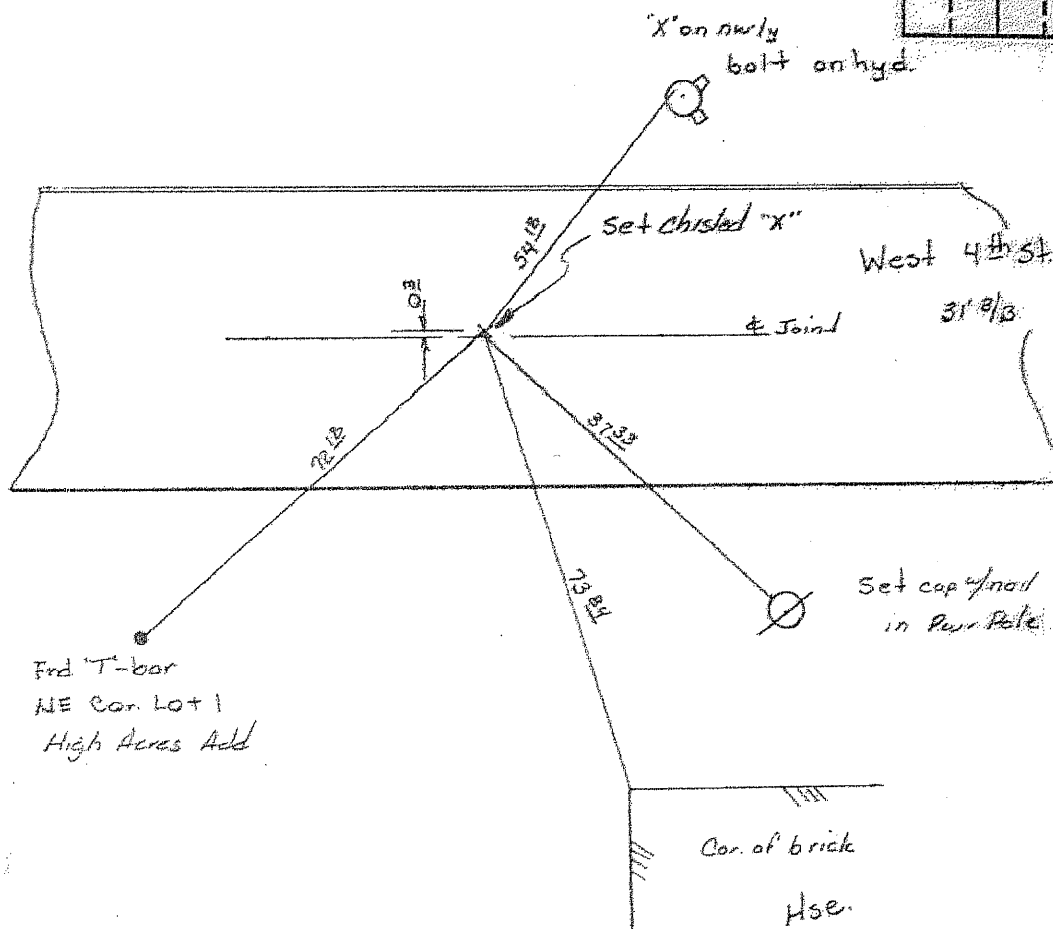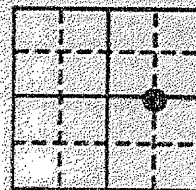

I hereby certify that the survey work was completed and this certificate was prepared by me or under my direct personal supervision and that I am a duly registered land surveyor under the laws of the state of Iowa.

Keith E. Vlademar May 8, 1991
 Keith E. Vlademar
 REGISTERED LAND SURVEYOR NO. 9781

List Corners to be Indexed

Corners	Section	Twp	Range
N.W. Cor.	10	89N	14W
N.E. & S.E. 1/4			

SEAL

