


Co. Eng. Ref. Only - This Corner Ref. is "NOT" a Cert.

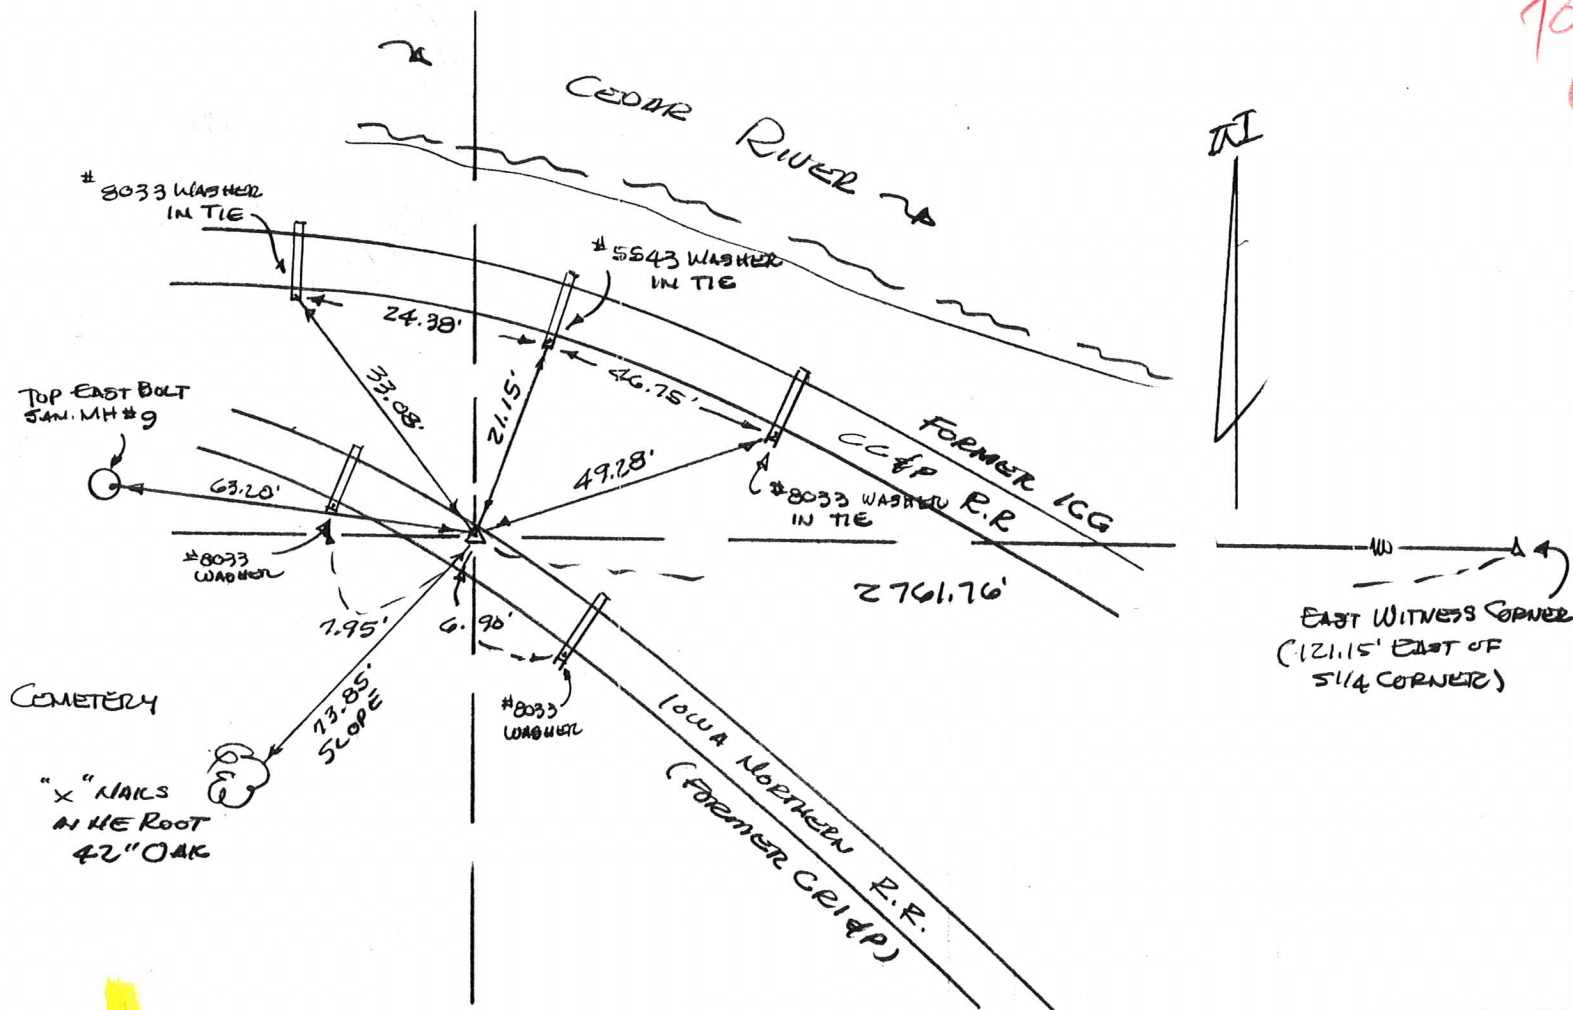

To Black Hawk Co. Engineer

NE Sec 11 - 89-14

SW CORNER SEC. 1-T89N-R14W
 5/8" x 30" REBAR 0.08 So. of North Rail
 Iowa Northern R.R. TRAIL
 RESULT FROM D.O.T. R.R. PROJECT CONTROL

CES

F. W. KING, R.L.S.

WAYNE CLAASSEN ENGINEERING AND SURVEYING, INC.
 2709 University Avenue
 P.O. Box 898
 Waterloo, Iowa 50704
 319/235-6294