Doc ID: 010142050003 Type: GEN Recorded: 04/30/2021 at 04:26:37 PM Fee Amt: \$22.00 Page 1 of 3 Black Hawk County Iowa SANDIE L. SMITH RECORDER File 2021-00022990 RESERVED FOR COUNTY RECORDER'S

Jeffrey P. Helland, 220 Clay Street, Cedar Falls, Iowa 50613, (319)-273-8606

UNITED STATES PUBLIC LAND SURVEY CORNER CERTIFICATE

OF

LAND SURVEY MONUMENTS SITUATED IN SECTION NO. 13, TOWNSHIP NO. 89 NORTH, RANGE NO. 14 WEST OF THE FIFTH PRINCIPAL MERIDIAN, BLACK HAWK COUNTY, IOWA.

MISC. BK 343 PG 216 PREVIOUSLY RECORDED IN


(Show reason for preparing this certificate, the evidence and detail procedures used in establishing the corner positions and monumentation found or placed.) MONUMENT DESCRIPTION AND REMARKS:

ALL REFERENCE TIES FROM MISC. BOOK 343 PAGE 216 HAVE BEEN OBLITERATED, MONUMENTATION HAS CHANGED. CORNER UTILIZED TO HELP REESTABLISHED THE N 1/4 CORNER OF SEC. 13.

E 1/4 CORNER: SURVEY BY JOHN W. HOLMES DATED 07/21-23/1857 CALLS FOR [THE EAST QUARTER POST WAS WANTING. WHICH WAS ESTABLISHED FOR THE PURPOSE OF DETERMINING OTHER CORNERS BY RUNNING FROM S.E. TO NORTH EAST CORNER PLACING IN MID-WAY], THIS SURVEY DOES NOT STATE WHAT WAS SET. IOWA DOT HIGHWAY COMMISSION CORNER STONE SURVEY BY ROBERT BURNS DATED 01/30/1980 CALLS FOR [CUT X IN LARGE ROCK OVER SET IRON PIN]. BLACK HAWK COUNTY ENGINEER REFERENCE TIES (NO DATE) CALLS FOR [CONCRETE MONUMENT], ALL REFERENCE TIES HAVE BEEN OBLITERATED. UNRECORDED PLAT OF SURVEY BY HENRY R. BEISNER DATED 02/16/1955 UTILIZED THE CORNER, BUT DOES NOT STATE WAS FOUND OR SET. "VALLEY PARK ADDITION" DATED 04/1956 CALLS FOR [FOUND CONC. MONUMENT]. PLAT OF SURVEY DATED 11/22/2002 IN FEE BOOK #2003-14370 CALLS FOR [FOUND REBAR]. USPLSCC DATED 06/28/2001 RECORDED IN MISC. BOOK 343 PAGE 216 CALLS FOR [FOUND 1/2" REBAR IN DIRT PER DOT TIES]. FOUND NO. 4 REBAR w/YPC #14674 (0.2'± DEEP) (THE LAND SURVEYOR WHOM PREPARED MISC. BOOK 343 PAGE 216 IS LICENSE #14674), BUT IT DID NOT CORRESPOND TO PLAT OF SURVEY IN FEE BOOK #2003-14370. EXCAVATED APPROXIMATELY 0.4' SOUTH AND 1.0' EAST OF FOUND NO. 4 REBAR w/YPC #14674, FOUND STANDARD CONCRETE MONUMENT w/BRASS CAP 2.3'± DEEP, UNABLE TO SET NO. 4 REBAR ABOVE AS NUMEROUS BOULDERS INTERFERED (EXCAVATED BENEATH THESE BOULDERS TO FIND THE CONCRETE MONUMENT). SET 1/4"Ø DRILL HOLE IN GRANITE STONE ABOVE SAID CONCRETE MONUMENT. THE BUILDINGS SHOWN PER MISC. BOOK 343 PAGE 216 ARE NOT THE SAME THAT EXIST TODAY. SAID FOUND NO. 4 REBAR W/YPC #14674 IS 0.41' NORTH & 0.95' WEST OF SAID FOUND STANDARD CONCRETE MONUMENT. IF UTILIZING THIS CORNER, VERIFY AT LEAST TWO REFERENCE TIES TO INSURE THAT THE GRANITE BOULDER HAS NOT MOVED.

(Show a minimum of three reference ties to durable physical objects, relevant monuments and physical conditions that will enable recovery of the corner.)

PLAN VIEW

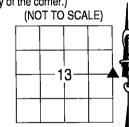

SEE SHEETS 2 AND 3

DEPARTMENT OF PUBLIC WORKS, ENGINEERING DIVISION

CITY of CEDAR FALLS, IOWA 220 CLAY ST. CEDAR FALLS, IOWA

(319) 273-8606

SSIONAL

JEFFREY P.

16264

AWO 1

SHEET 1 OF 3

I hereby certify that this land surveying document was prepared and the related survey work was performed by me or under my direct personal supervision and that I am a duly licensed Land Surveyor under the laws

of the State of Iowa

lland, L.S.

Date: lowa License No. 16264

renewal date is December 31, 2021. All Pages or Sheets are covered by this Seal except:

OPC = PLASTIC CAP (O=ORANGE,R=RED,Y=YELLOW) DRAWN BY: JPH


FILE NAME: E 0.25 CORNER SEC. 13-T89N-R14W.dwg

(00') RECORDED AS

LIST CORNERS TO BE INDEXED			
CORNER	SECTION	TOWNSHIP	RANGE
E 1/4 CORNER W 1/4 CORNER	13 18	89N 89N	14W 13W

H:\2020 SURVEY JOBS\USPLSCC\NE CORNER SEC. 13-T89N-R14W\E 0.25 CORNER SEC.13-T89N-R14W.dwg

Jeffrey P. Helland, 220 Clay Street, Cedar Falls, Iowa 50613, (319)-268-5173

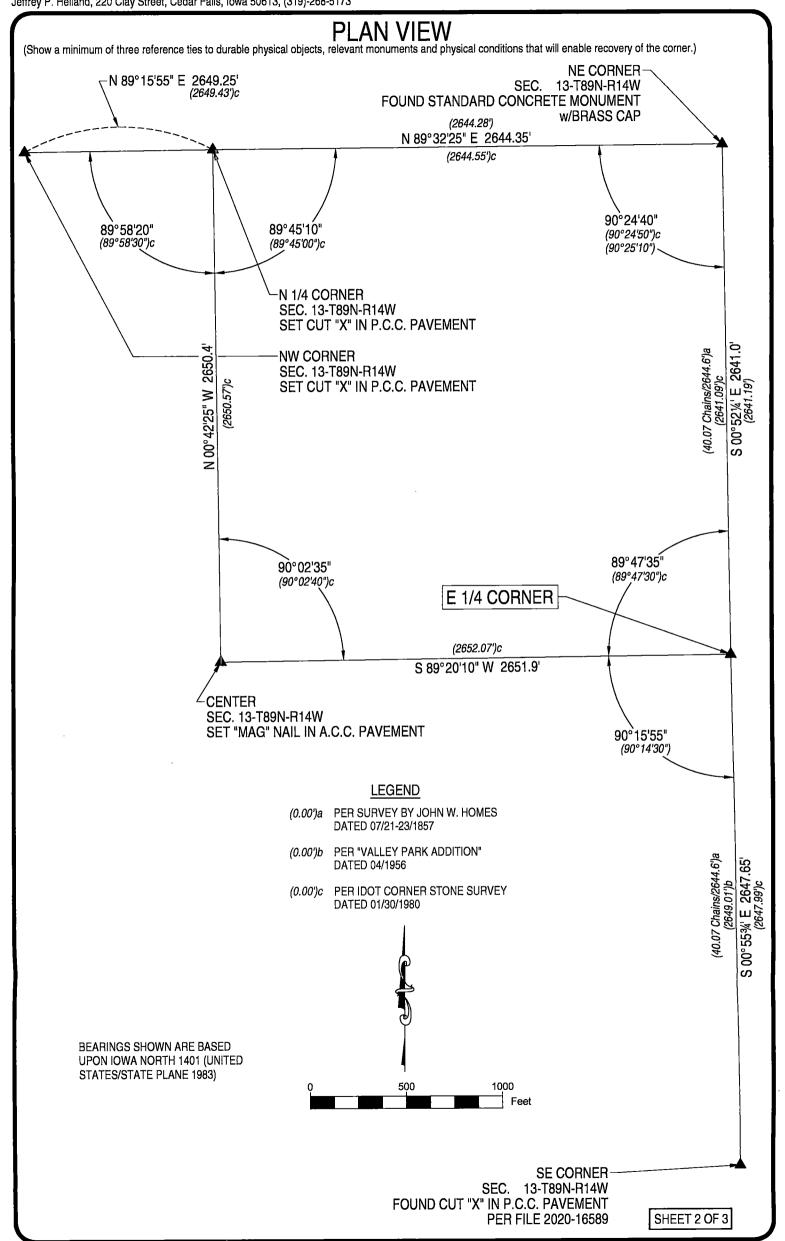

Jeffrey P. Helland, 220 Clay Street, Cedar Falls, Iowa 50613, (319)-268-5173

