



Michael R. Fagle, P.L.S. AECOM, 501 Sycamore St., Suite 222, Waterloo, Iowa 50703 1-319-232-6531

UNITED STATES PUBLIC LAND SURVEY CORNER CERTIFICATE
OF

Land Survey Monuments situated in Section 14, Township 89 North,
Range 14 West, of the Fifth Principal Meridian, Black Hawk
County, Iowa. Previously recorded in NA
in County Recorder's Office. (Book, Page, Document Number, etc.)


(Show reason for preparing this certificate, the evidence and detailed procedures used in establishing the corner positions and monumentation found or placed.)

Monument Description and Remarks: Found IDOT Aluminum Disk. Corner was cover with asphalt during the City of Cedar Falls 2108 Street Construction Project. Set a 3" long mag nail with a 1" diameter head stamped Survey Marker.


PLAN - VIEW

(Show a minimum of three reference ties to durable physical objects, relevant monuments and physical conditions that will enable recovery of the corner.)

Also the West Corner Sec. 23-89-14W

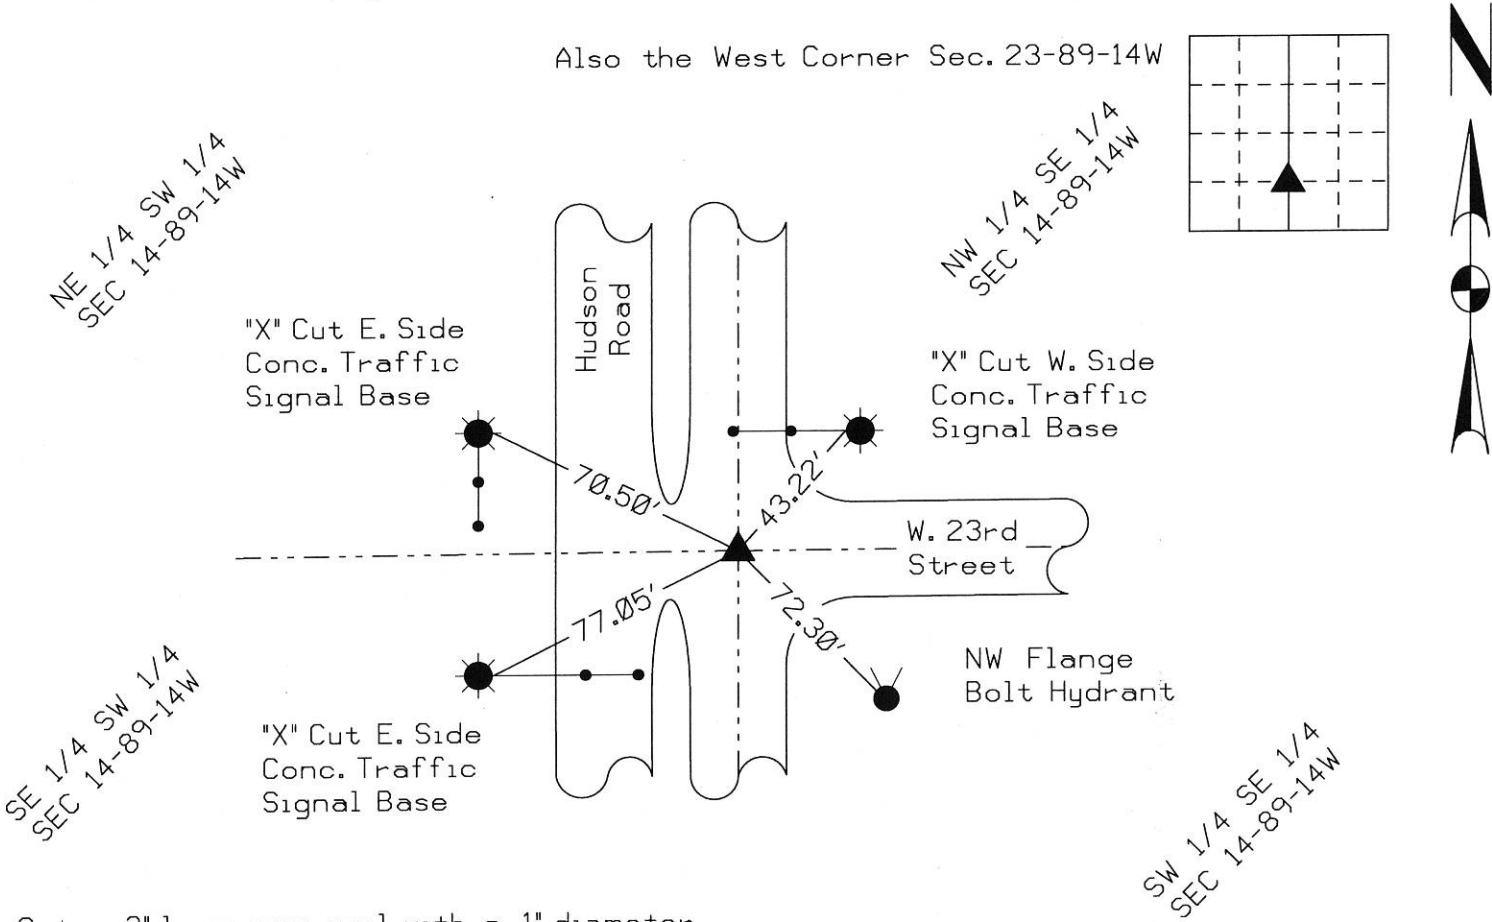

Set a 3" long mag nail with a 1" diameter head stamped Survey Marker.

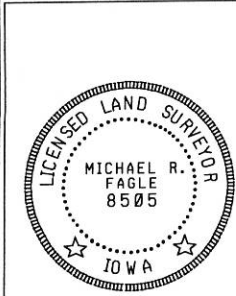

I hereby certify that this Land Surveying document was prepared by me or under my direct personal supervision and that I am a duly Licensed Land Surveyor under the laws of the State of Iowa.
Michael R. Fagle 1-04-2019
MICHAEL R. FAGLE Date
License number 8505
My license renewal date is December 31, 2020
Pages or sheets covered by this seal:
THIS SHEET

| List Corners to be Indexed | | | |
|--|---------|--------|--------|
| Corners | Section | Twp | Range |
| Northeast Corner of the Southeast 1/4 of the Southwest 1/4 | 14 | T 89 N | R 14 W |