

EARTH TECH
501 SYCAMORE ST STE 222
WATERLOO IA 50703

I VS
P
Z

Document Number: 2007008748
Date: Oct 16, 2006 3:12:05 pm
Aud Fee: 0.00 Rec Fee: 5.00
Trans Tax: 0.00 Rec Management Fee: 1.00
E-Com Fee: 1.00 Non-Standard Page Fee: 0.00
Filed for record in Black Hawk County, Iowa
Patricia S. Sass, County Recorder

Recorded By: Michael R. Fagle, P.L.S.

Earth Tech, 501 Sycamore St., Suite 222, Waterloo, Iowa 50703

I-319-232-6531

UNITED STATES PUBLIC LAND SURVEY CORNER CERTIFICATE OF


Land Survey Monuments situated in Section 14, Township 89 North,
Range 14 West, of the Fifth Principal Meridian, Black Hawk
County, Iowa. Previously recorded in _____
in County Engineer's Office. (Book, Page, Document Number, etc.)


(Show reason for preparing this certificate, the evidence and detailed procedures
used in establishing the corner positions and monumentation found or placed.)

Monument Description and Remarks:
NORTH 1/4 CORNER SEC. 14-89-14 FOUND 'X' CUT IN ALUMINUM DISK.
CENTER SEC. 14-89-14 FOUND 'X' CUT IN ALUMINUM DISK.
SOUTH 1/4 CORNER SEC. 14-89-14 FOUND CORED HOLE WHERE ALUMINUM DISK WAS.
TALK TO CITY SURVEYOR AND THEY VARIFIED LOCATION FROM SOUTHWEST CORNER.

PLAN - VIEW

(Show a minimum of three reference ties to durable physical objects, relevant
monuments and physical conditions that will enable recovery of the corner.)

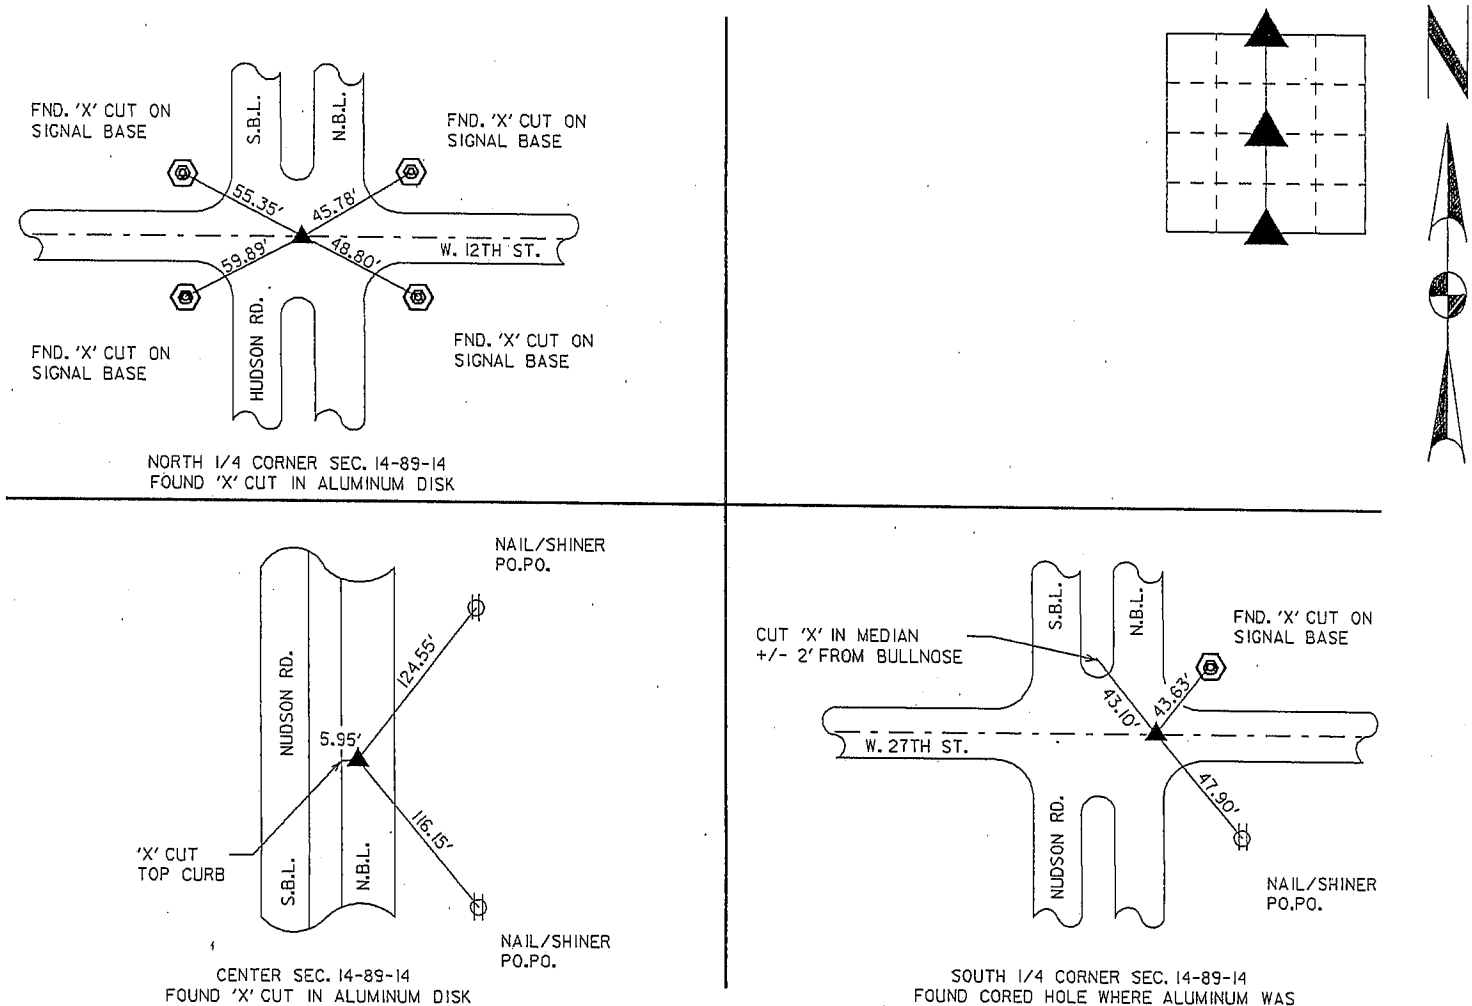

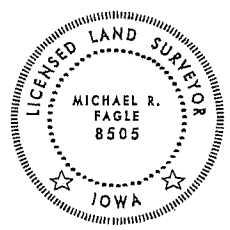	<p>I hereby certify that this Land Surveying document was prepared by me or under my direct personal supervision and that I am a duly Licensed Land Surveyor under the laws of the State of Iowa.</p> <p><u>Michael R. Fagle</u> <u>10-16-06</u> MICHAEL R. FAGLE Date</p> <p>License number 8505 My license renewal date is December 31, 2006 Pages or sheets covered by this seal:</p>	<p>List Corners to be Indexed</p> <table border="1"><thead><tr><th>Corners</th><th>Section</th><th>Twp</th><th>Range</th></tr></thead><tbody><tr><td>North 1/4 Corner</td><td>14</td><td>T 89 N</td><td>R 14 W</td></tr><tr><td>Center Section</td><td>14</td><td>T 89 N</td><td>R 14 W</td></tr><tr><td>South 1/4 Corner</td><td>14</td><td>T 89 N</td><td>R 14 W</td></tr></tbody></table>			Corners	Section	Twp	Range	North 1/4 Corner	14	T 89 N	R 14 W	Center Section	14	T 89 N	R 14 W	South 1/4 Corner	14	T 89 N	R 14 W
	Corners	Section	Twp	Range																
North 1/4 Corner	14	T 89 N	R 14 W																	
Center Section	14	T 89 N	R 14 W																	
South 1/4 Corner	14	T 89 N	R 14 W																	
	<p>THIS SHEET</p>																			