

SC
MISC
INDEX
MARGIN
PROOF
COMPARE

BLACK HAWK COUNTY IOWA:SS 475
FILED FOR RECORD JULY 6, 1999 AT
4:00 P. M. AND RECORDED IN BOOK 334
OF MISC PAGE 997 .
RECORDER
FEE 1-5.00/
CITY OF CEDAR FALLS

R. Allen Dietz, L.S. for the City of Cedar Falls
217 Washington Street Cedar Falls, Iowa 50613 Ph. (319) 273-8606

UNITED STATES PUBLIC LAND SURVEY CORNER CERTIFICATE OF

Land Survey Monuments situated in Section No. 15, Township No. 89 North, Range
No. 14 West, of the Fifth Principal Meridian, Black Hawk County, Iowa.
Previously recorded in Book N/A on Page N/A in the office of the County Recorder.
(book, page, document number, etc.)


(Show reason for preparing this certificate, the evidence and detailed procedures used in establishing the corner positions and
monumentation found or placed.)

Monument Description and Remarks: Found "X" in concrete pavement before
construction.

Cut an "X" in new concrete pavement after street reconstruction using project
coordinates.

PLAN - VIEW

(Show a minimum of three reference ties to durable physical objects, relevant monuments and physical conditions that will enable
recovery of the corner.)

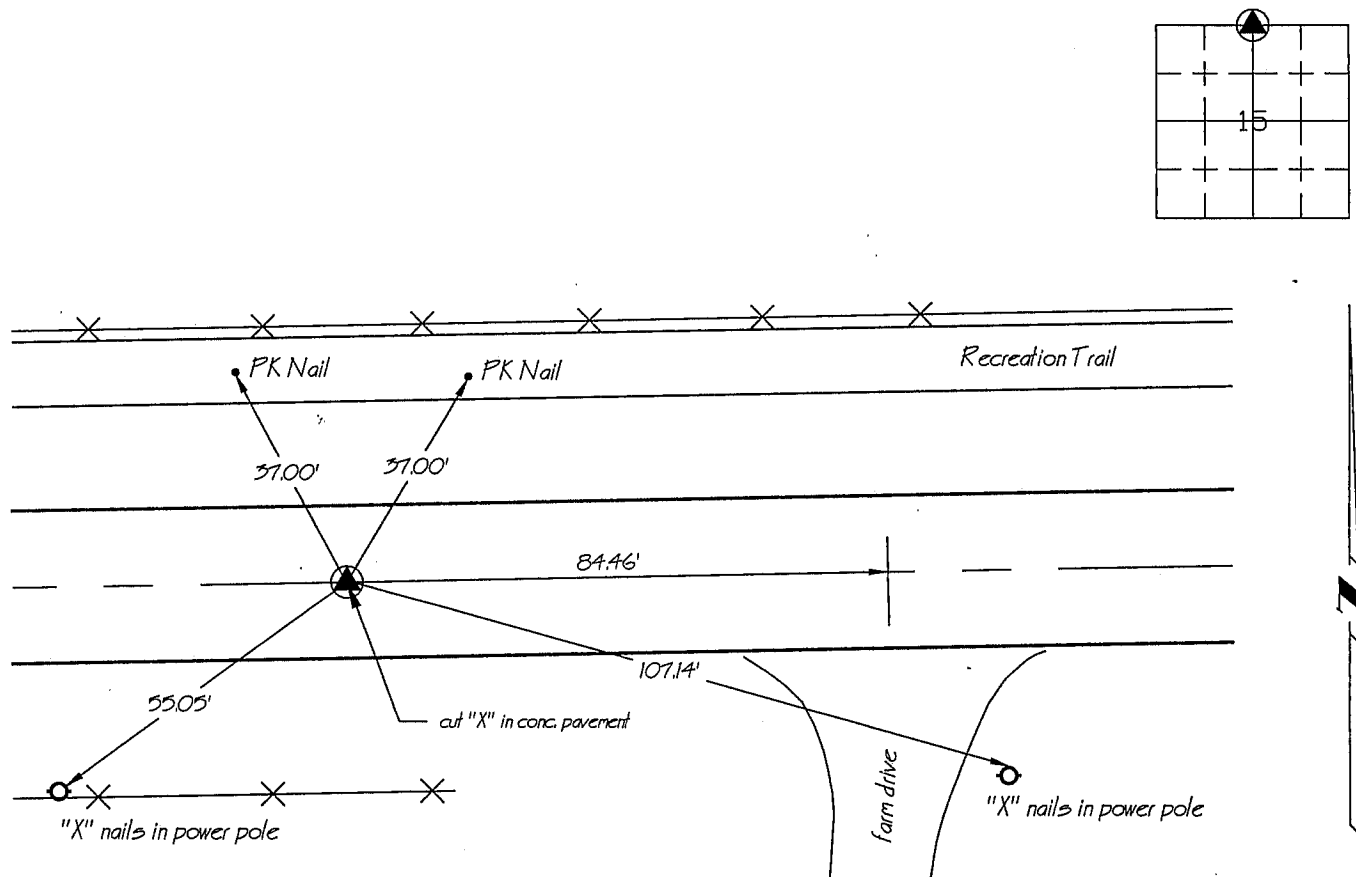


ALL DISTANCES SHOWN ARE SLOPED DISTANCE.

I hereby certify that this land surveying document was prepared
by me or under my direct personal supervision and that I am
a duly licensed Professional Land Surveyor under the laws of
the State of Iowa.

Signed: R. Allen Dietz
R. Allen Dietz Iowa License No. 12086

Date: 1 July 1999

SEAL

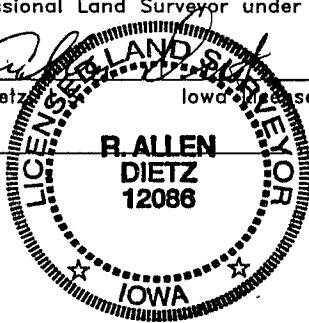

Corners	List Corners to be Indexed Section	Twp	Range
N $\frac{1}{4}$	15	89	14

334 PAGE 997

My License renewal date is December 31, 2000.
Pages or sheets covered by this seal : this page only

Drawn by : RR

Checked by : RAD