




Doc ID: 009442470001 Type: GEN
Recorded: 12/04/2018 at 12:57:20 PM
Fee Amt: \$7.00 Page 1 of 1
Black Hawk County Iowa
SANDIE L. SMITH RECORDER

File 2019-00008714

Env * Prepared by/Return to: FEHR GRAHAM, 128 S. Vine Street, West Union, IA 52175 - Ph. (563)422-5131

UNITED STATES PUBLIC LAND SURVEY CORNER CERTIFICATE
BLACK HAWK COUNTY, IOWA
SECTION 15-T89N-R14W

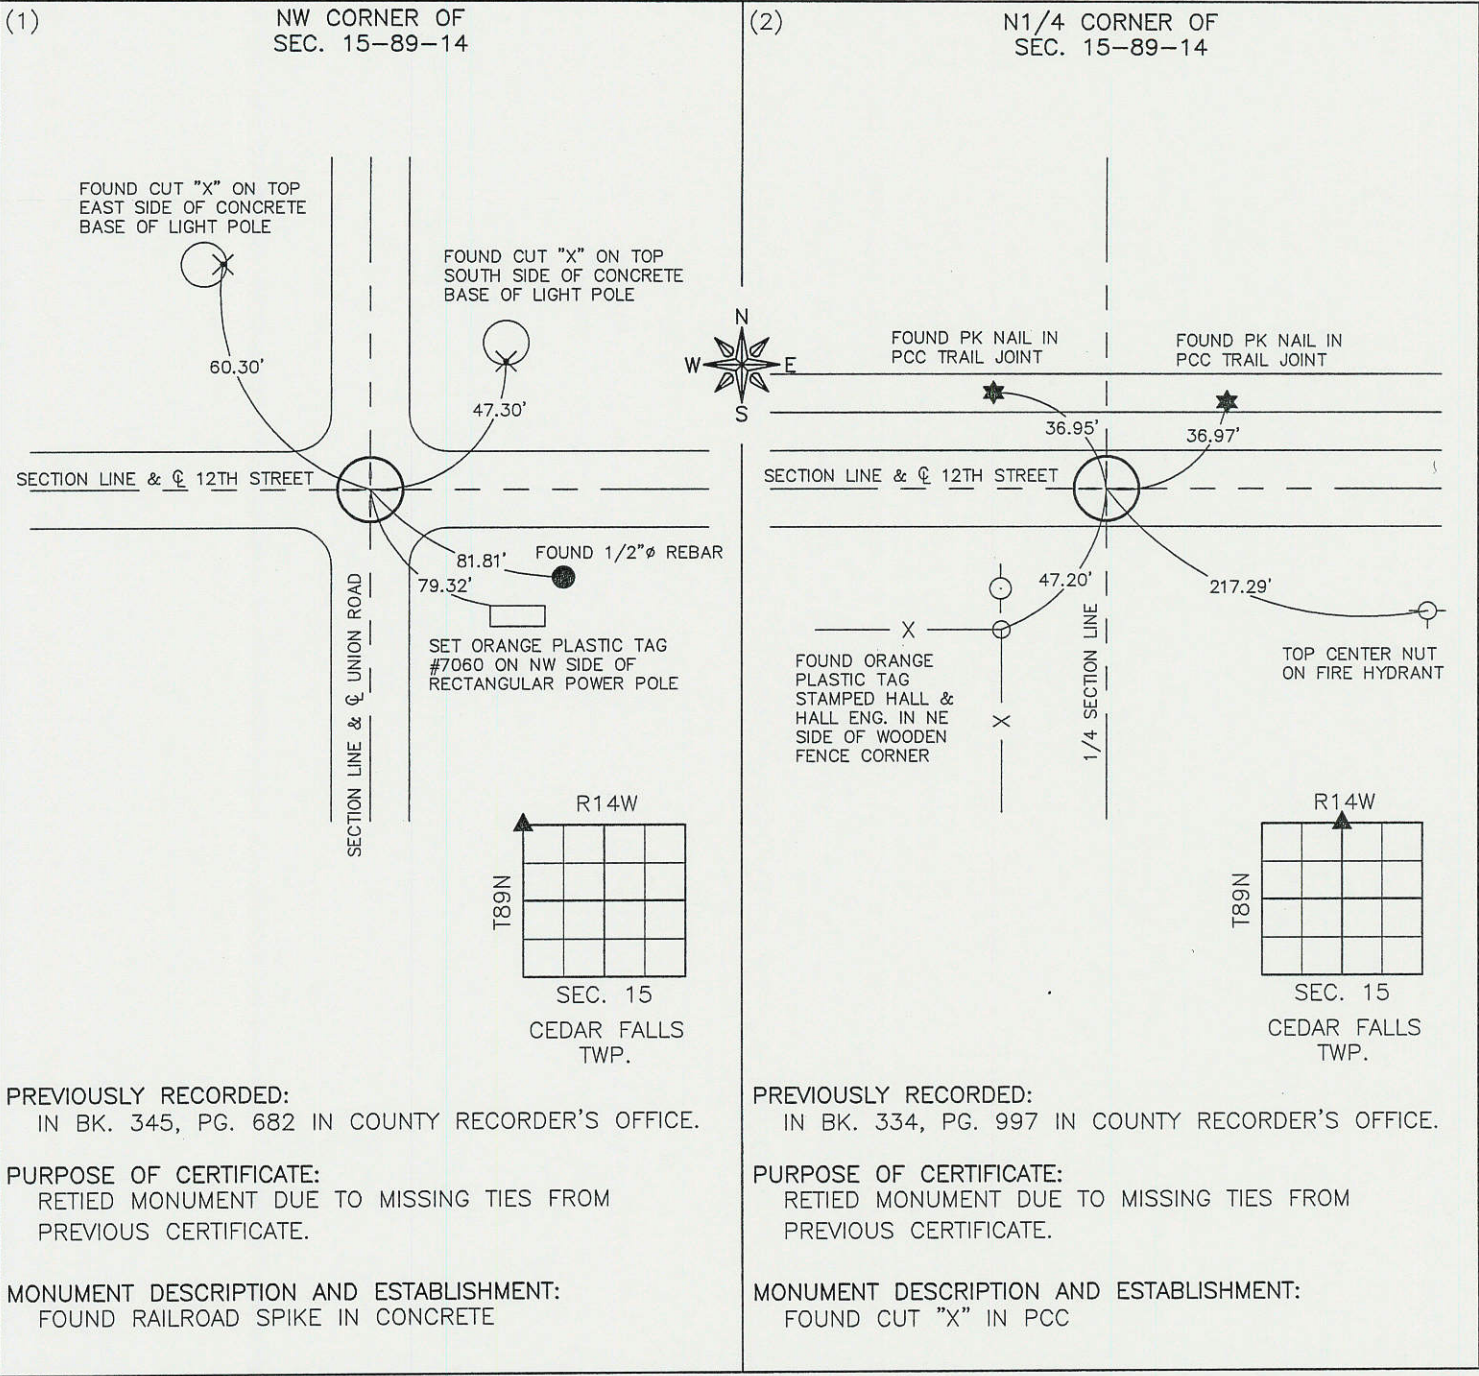

PREVIOUSLY RECORDED:
IN BK. 345, PG. 682 IN COUNTY RECORDER'S OFFICE.

PURPOSE OF CERTIFICATE:
RETIED MONUMENT DUE TO MISSING TIES FROM PREVIOUS CERTIFICATE.

MONUMENT DESCRIPTION AND ESTABLISHMENT:
FOUND RAILROAD SPIKE IN CONCRETE

PREVIOUSLY RECORDED:
IN BK. 334, PG. 997 IN COUNTY RECORDER'S OFFICE.

PURPOSE OF CERTIFICATE:
RETIED MONUMENT DUE TO MISSING TIES FROM PREVIOUS CERTIFICATE.

MONUMENT DESCRIPTION AND ESTABLISHMENT:
FOUND CUT "X" IN PCC

CORNERS TO BE INDEXED

| | CORNER | SECTION | TOWNSHIP | RANGE |
|-----|--------|---------|----------|-------|
| (1) | NW | 15 | 89N | 14W |
| (2) | N1/4 | 15 | 89N | 14W |



I hereby certify that this land surveying document was prepared and the related survey work was performed by me or under my direct personal supervision and that I am a duly licensed Land Surveyor under the laws of the State of Iowa.

Lyle G. TeKippe 12-3-18
Lyle G. TeKippe, P.E. & P.L.S. Date
License Number: 7060
My license renewal date is December 31, 2018.
Sheets covered by this seal: Sheet 1

FEHR GRAHAM
ENGINEERING & ENVIRONMENTAL
© 2018 FEHR GRAHAM

ILLINOIS
IOWA
WISCONSIN

G:\C3D\18\18-868-NEWALDAYA\15-89-14AC.dwg

JOB NUMBER:
18-868

SHEET NUMBER:
1 of 1