

SC  
MISC  
INDEX  
MARGIN  
PROOF  
COMPARE

BLACK HAWK COUNTY IOWA:SS  
Filed for record Dec 7, 1998 at  
4:00 P.M. and recorded in Book 332  
of MISC Page 485.  
Recorder  
Fee N/C  
ENGINEER'S OFFICE

13360

PREPARED BY: BLACK HAWK COUNTY ENGINEERS OFFICE  
316 E. FIFTH STREET, ROOM 211 WATERLOO, IOWA 50703

PH# (319) 291-2419  
FAX# (319) 291-2461  
SLSI 9-94  
CERT 12-98

UNITED STATES PUBLIC LAND SURVEY CORNER CERTIFICATE OF  
Land Survey Monuments situated in Section 19, Township 89 N,  
Range 14 W, of the Fifth Principal Meridian, BLACK HAWK County, Iowa.  
Previously recorded in Misc. Book N/A, Page N/A, in County Recorder's Office.

(Show reason for preparing this certificate, the evidence and detailed procedures used in establishing the corner positions and monumentation found or placed.)


Monument Description and Remarks: N. 1/4 CORNER SECT. 19-89-14  
FOUND RESET 5/8" REBAR FLUSH W/ A.C.C. SURFACING. FIELD RECOVERED  
ONE REF. TIE FROM RE-TIE IN 6/81. RECOVERED THREE ADDITIONAL REF.  
TIES WITH L.S. TAG & NAIL #6505, WITH ONE SAID TIE DISTURBED.  
NO CORNER CERTIFICATE FOUND ON RECORD TO DATE. RE-TIED FROM 1995  
RESURFACING PROJECT AND REFERENCE TIE UPDATE SPRING 1997.

### PLAN - VIEW

(Show a minimum of three reference ties to durable physical objects, relevant monuments and physical conditions that will enable recovery of the corner.)

NOTE: ALL DISTANCES PLUMB  
UNLESS DENOTED.


NOT TO SCALE

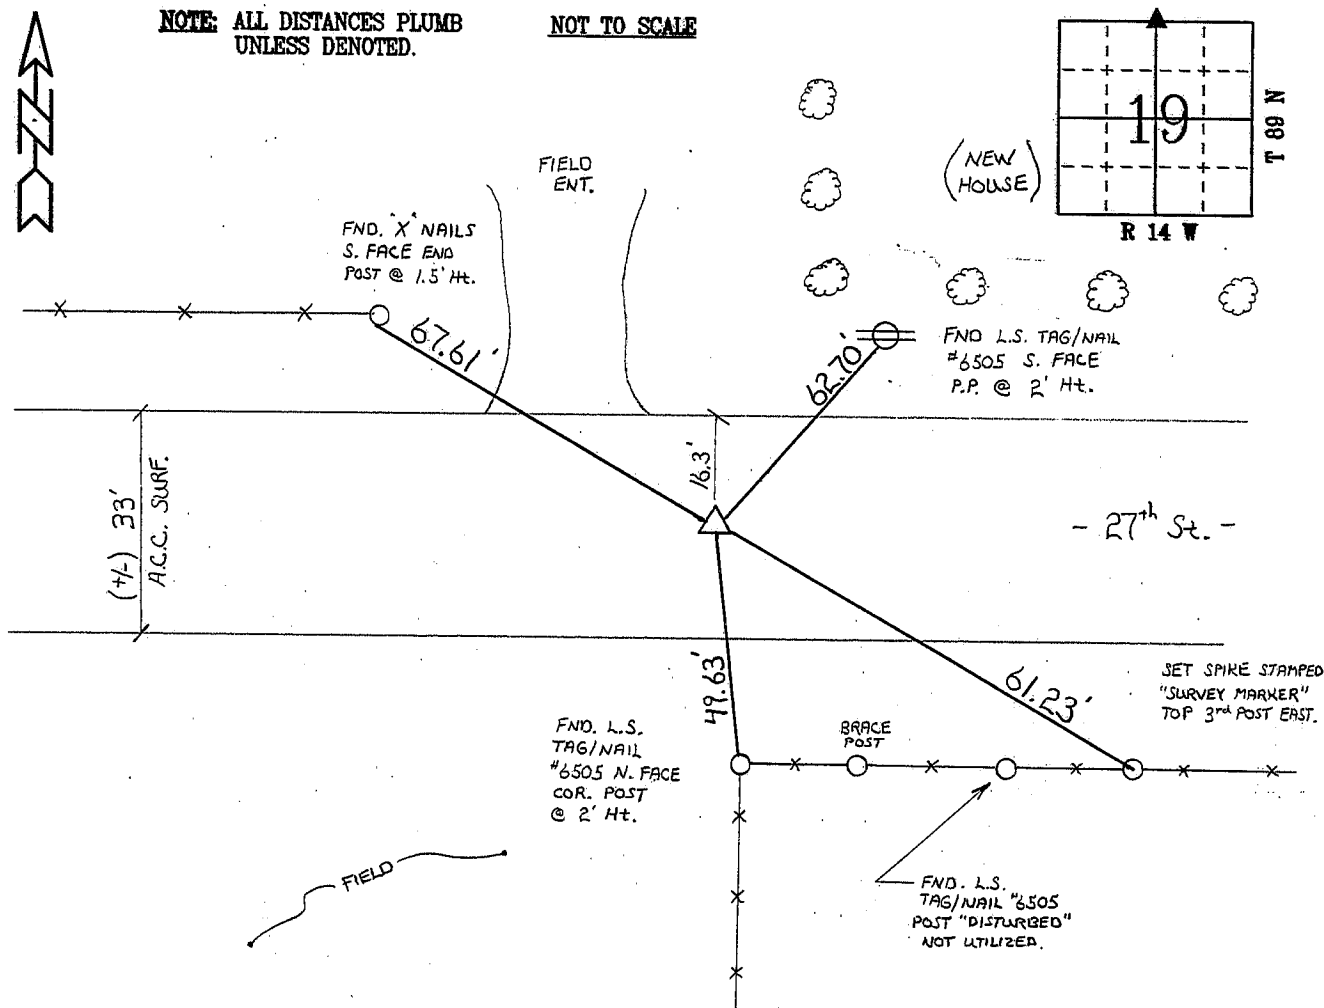

NOTE: CORNER CERTIFICATE FILED TO REPLACE COUNTY  
PRESERVATION RECORD DATED 5/19/97

FIELD SURVEY: G.T. & B.S. APRIL 1997  
PREPARED BY: C.W. & G.T. 12/01/98

### CERTIFICATION

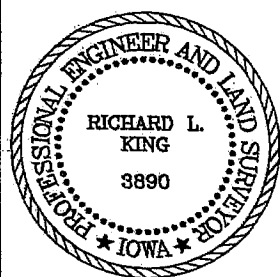

I hereby certify that this land surveying document  
was prepared and the related survey work was  
performed by me or under my direct personal  
supervision and that I am a duly licensed Land  
Surveyor under the laws of the State of Iowa.

Richard L. King 12/5/98  
Richard L. King (date)

License Number 3890  
My license renewal date is December 31, 1999

Pages or sheets covered by this seal:  
This Land Corner Certificate Only.

### LIST CORNERS TO BE INDEXED

Corner	Section	Township	Range
N. 1/4	19	89 N	14 W