

MISC SC  
INDEXED  
MARGIN  
PROOF  
COMPAREY

BLACK HAWK COUNTY IOWA:SS  
Filed for record Dec 7, 1998 at  
4:00 P.M. and recorded in Book 332  
of MISC Page 484.

13359

*Richard L. King* Recorder  
Fee N/C  
ENGINEER'S OFFICE

PREPARED BY: BLACK HAWK COUNTY ENGINEERS OFFICE  
316 E. FIFTH STREET, ROOM 211 WATERLOO, IOWA 50703

PL# (319) 291-2419  
FAX# (319) 291-2461  
SL# 9-94  
CERT 12-96


UNITED STATES PUBLIC LAND SURVEY CORNER CERTIFICATE OF  
Land Survey Monuments situated in Section 19, Township 89 N,  
Range 14 W, of the Fifth Principal Meridian, BLACK HAWK County, Iowa.  
Previously recorded in Misc. Book N/A, Page N/A, in County Recorder's Office.

(Show reason for preparing this certificate, the evidence and detailed procedures used in establishing the corner positions and monumentation found or placed.)

Monument Description and Remarks: N.E. CORNER SECT. 19-89-14  
FOUND RESET 5/8" REBAR FLUSH W/ A.C.C. SURFACING. NO PRIOR REF. TIES  
OF RECORD WERE FIELD RECOVERED, HOWEVER ONE SET OF TIES WAS FIELD  
RECOVERED FROM UNKNOWN ORIGIN. EST. THREE ADDITIONAL SETS OF REF.  
TIES. RE-TIED FROM 1995 RESURFACING PROJECT AND REF. TIE UPDATE  
SPRING 1997.

### PLAN - VIEW


(Show a minimum of three reference ties to durable physical objects, relevant monuments and physical conditions that will enable recovery of the corner.)

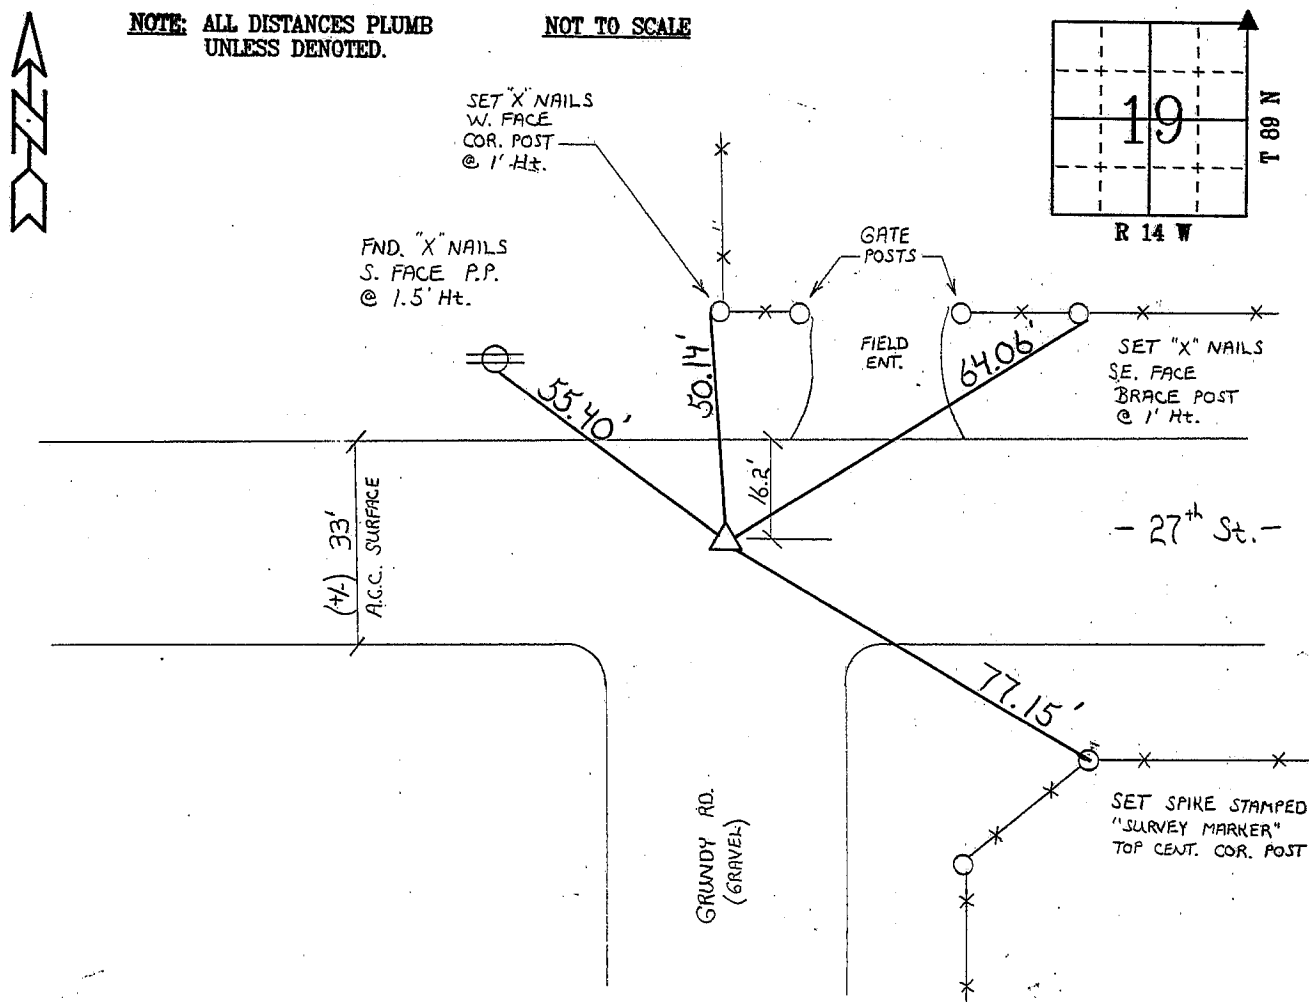

**NOTE:** CORNER CERTIFICATE FILED TO REPLACE COUNTY  
PRESERVATION RECORD DATED 5/19/97

FIELD SURVEY: G.T. & B.S. APRIL 1997  
PREPARED BY: C.W. & G.T. 12/01/98

### CERTIFICATION

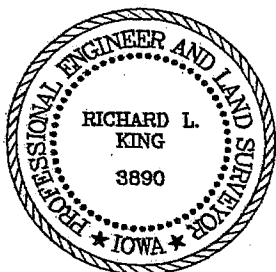

I hereby certify that this land surveying document  
was prepared and the related survey work was  
performed by me or under my direct personal  
supervision and that I am a duly licensed Land  
Surveyor under the laws of the State of Iowa.  
*Richard L. King* 12/5/98 (date)  
Richard L. King  
License Number 3890  
My license renewal date is December 31, 1999  
Pages or sheets covered by this seal:  
This Land Corner Certificate Only.

### LIST CORNERS TO BE INDEXED

Corner	Section	Township	Range
N.E.	19	89 N	14 W