

SC  
Misc  
INDEX  
MARGIN  
PROOF  
COMPARE

BLACK HAWK COUNTY IOWA:SS 21755  
Filed for record MAY 22, 1997  
at 4:00PM, and recorded in Book 325  
of Misc Page 470  
*Catherine J. Sass* Recorder  
Fee N/C  
ENGINEER'S OFFICE

PREPARED BY: BLACK HAWK COUNTY ENGINEERS OFFICE PH.# (319) 291-2419 SLSI 8-94  
316 E. FIFTH STREET, ROOM 211 WATERLOO, IOWA 50703 FAX.# (319) 291-2461 CERT 12-96


UNITED STATES PUBLIC LAND SURVEY CORNER CERTIFICATE OF  
Land Survey Monuments situated in Section 19, Township 89 N,  
Range 14 W, of the Fifth Principal Meridian, BLACK HAWK County, Iowa.  
Previously recorded in Book 315, Page 369, in County Recorder's Office.  
(MISC.)

(Show reason for preparing this certificate, the evidence and detailed procedures used in establishing the corner positions and monumentation found or placed.)

Monument Description and Remarks: FOUND 5/8" REBAR CENTERLINE OF  
27th ST. INTERSECTION WITH BUTLER ROAD. FOUND AND UTIL. 2 REF. TIES  
WITH 3 ADDITIONAL SETS FOUND "DISTURBED". RESET 3 NEW REF. TIES AS  
DENOTED. MONUMENT REF'ED AS IRON PIN IN 3-95, AND UPDATED TO RESET  
5/8" REBAR FROM 1995 RESURFACING PROJECT.  
CERT. FILED TO UPDATE PRIOR REFERENCES AND TIE DESCRIPTIONS.


PLAN - VIEW

(Show a minimum of three reference ties to durable physical objects, relevant monuments and physical conditions that will enable recovery of the corner.)

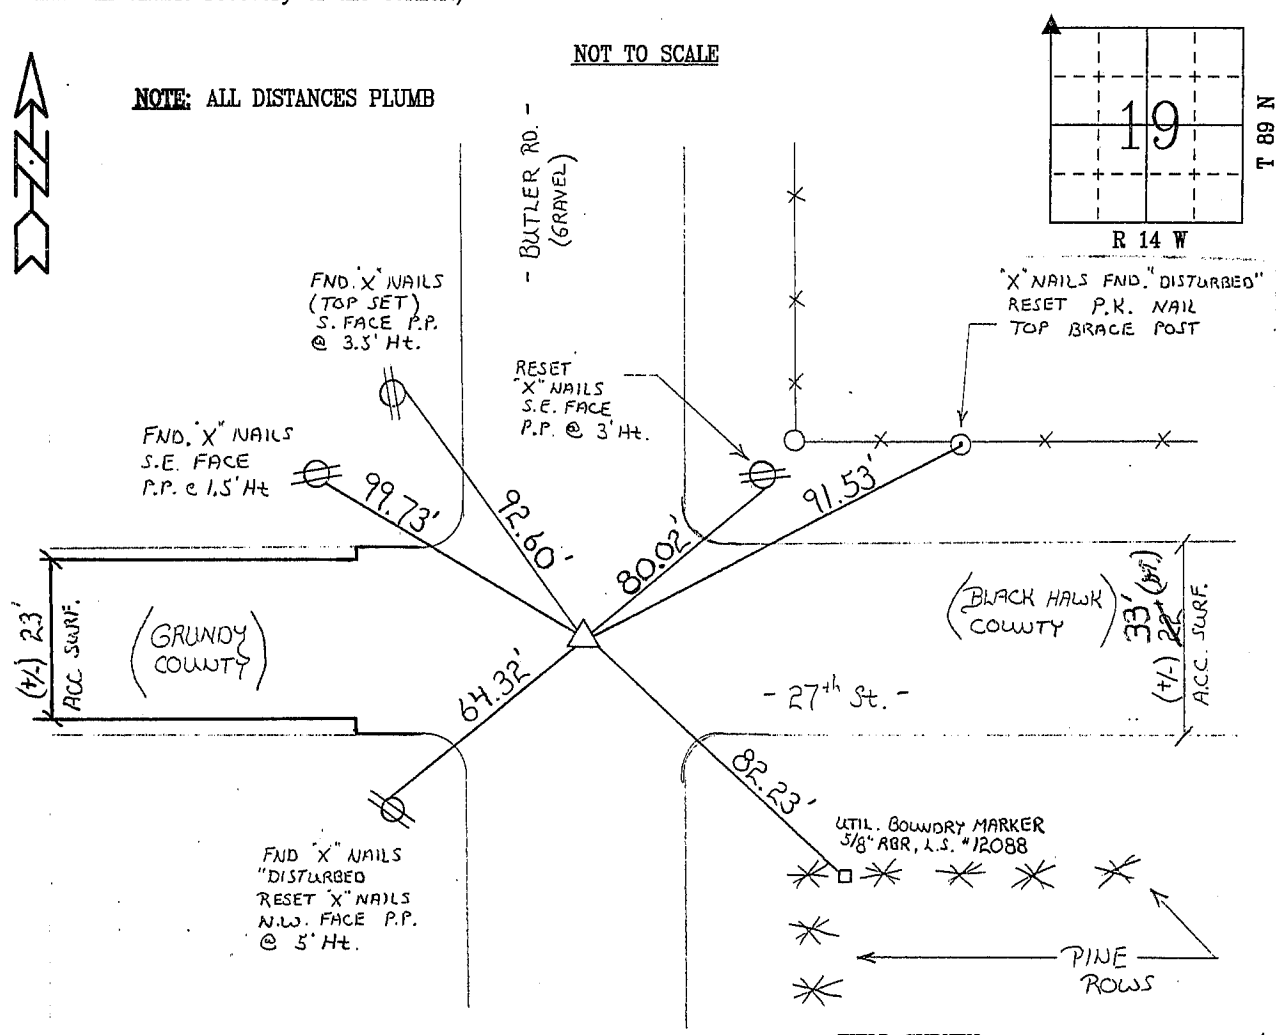

FIELD SURVEY: G. TINKER 4/97  
PREPARED BY: G. TINKER 5/97

CERTIFICATION

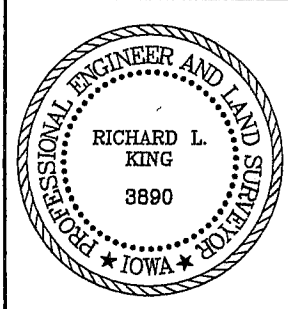

I hereby certify that this land surveying document was prepared and the related survey work was performed by me or under my direct personal supervision and that I am a duly licensed Land Surveyor under the laws of the State of Iowa.  
*Richard L. King* 5/19/97 (date)  
Richard L. King  
License Number 3890  
My license renewal date is December 31, 1997  
Pages or sheets covered by this seal:  
This Land Corner Certificate Only.

LIST CORNERS TO BE INDEXED

Corner	Section	Township	Range
N.W. COR.	19	89 N	14 W