

Michael R. Fagle, P.L.S.

AECOM, 501 Sycamore St., Suite 222, Waterloo, Iowa 50703

I-319-232-6531

## UNITED STATES PUBLIC LAND SURVEY CORNER CERTIFICATE OF


Land Survey Monuments situated in Section 22, Township 89 North,  
Range 14 West, of the Fifth Principal Meridian, Black Hawk  
County, Iowa. Previously recorded in Misc. Book 301 Page 920  
in County Recorder's Office. (Book, Page, Document Number, etc.)

(Show reason for preparing this certificate, the evidence and detailed procedures used in establishing the corner positions and monumentation found or placed.)

Monument Description and Remarks: Found Standard Concrete Monument from  
previous ties. Monument was destroyed during construction of Greenhill Road.  
Reset a 2 1/2" Brass Disk marked LS 8505 in a concrete driveway.

### PLAN - VIEW

(Show a minimum of three reference ties to durable physical objects, relevant monuments and physical conditions that will enable recovery of the corner.)

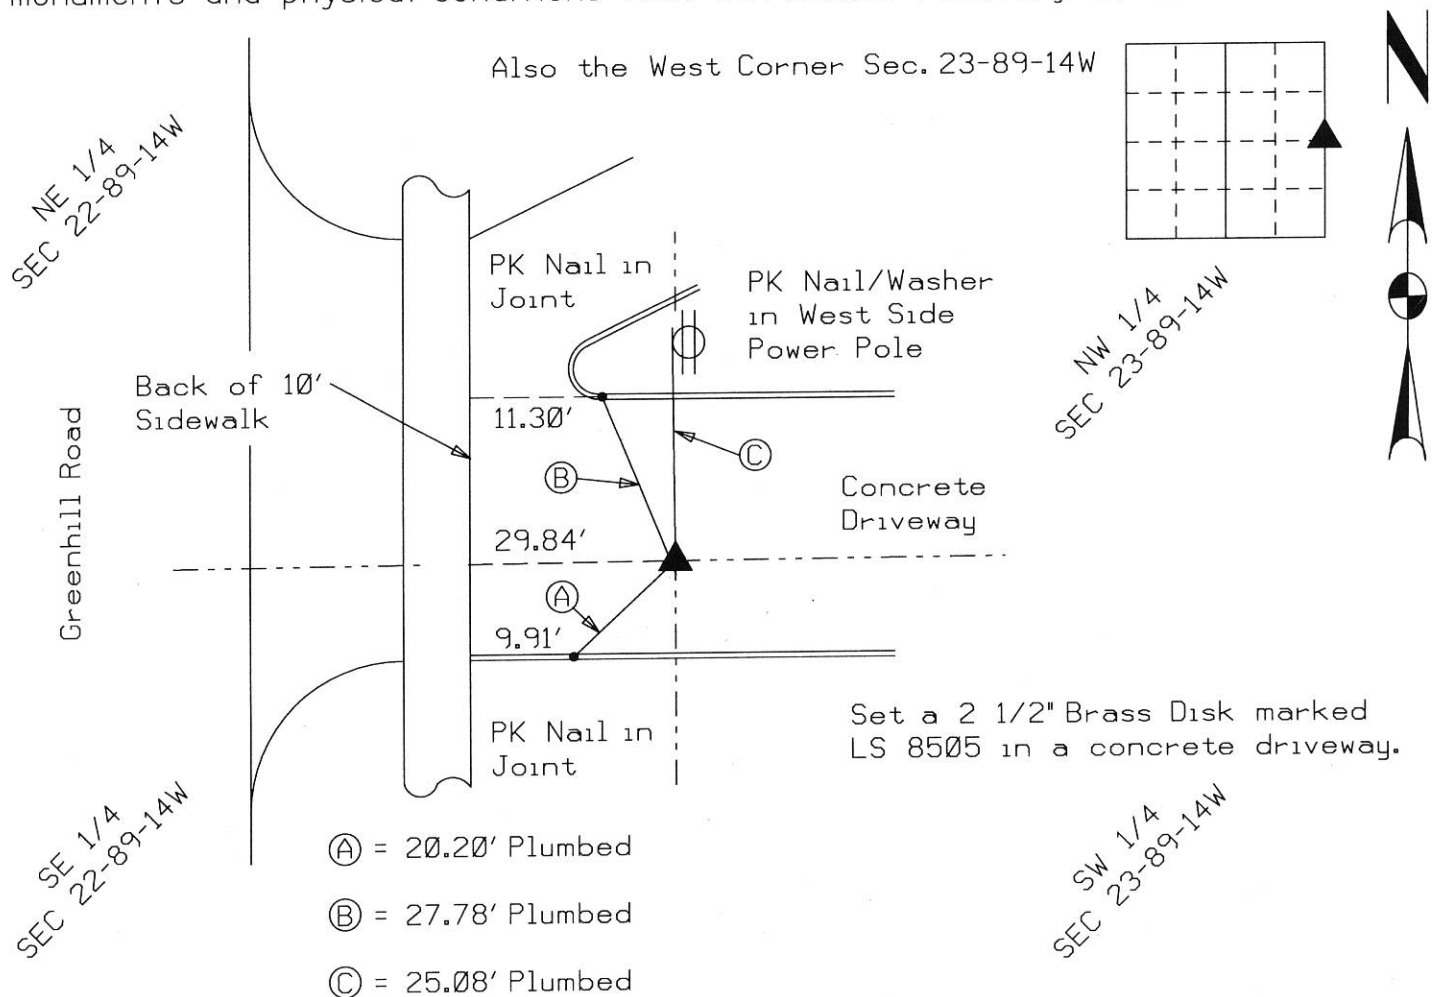

I hereby certify that this Land Surveying document was prepared by me or under my direct personal supervision and that I am a duly Licensed Land Surveyor under the laws of the State of Iowa.

Michael R. Fagle 1-10-2019  
Date

MICHAEL R. FAGLE  
License number 8505

My license renewal date is December 31, 2020

Pages or sheets covered by this seal:  
THIS SHEET

#### List Corners to be Indexed

Corners	Section	Twp	Range
East 1/4 Corner	22	T 89 N	R 14 W
Also, West 1/4 Corner	23	T 89 N	R 14 W