

UNITED STATES PUBLIC LAND SURVEY CORNER CERTIFICATE

OF

Land Survey Monuments situated in Section 22, Township 89N, Range 14W, of the Fifth Principal Meridian, BLACK HAWK County, Iowa.
Previously recorded in N/A in County Recorder's Office.


(book, page, document number, etc.)

Show reason for preparing this certificate, the evidence and detailed procedures used in establishing the corner positions and monumentation found or placed.)

Monument Description and Remarks: FOUND STD. CONC. MONUMENT IN PAVING BOX

PLAN - VIEW

(Show a minimum of three reference ties to durable physical objects, relevant monuments and physical conditions that will enable recovery of the corner.)

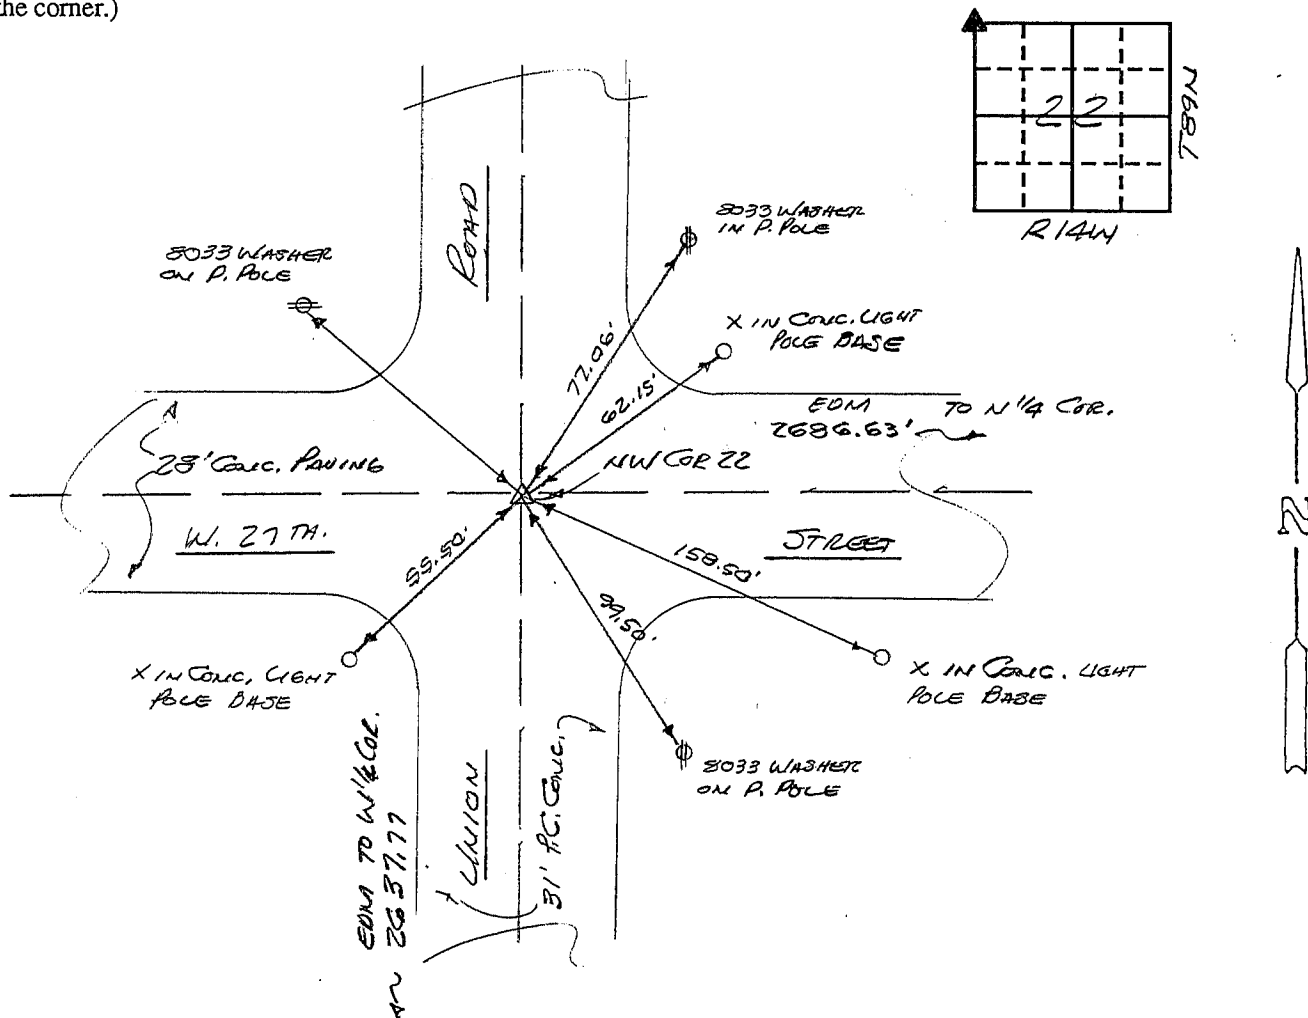

352-39

I hereby certify that the survey work was completed and this certificate was prepared by me or under my direct personal supervision and that I am a duly registered land surveyor under the laws of the state of Iowa.

Signature:


Name typed or printed:

F. WILLIAM KING

Date: 6-22-1992

Reg. No. 8033

Corners	List Corners to be Indexed	Section	Twp	Range
NE	22	89N	14W	
NE	21	89N	14W	

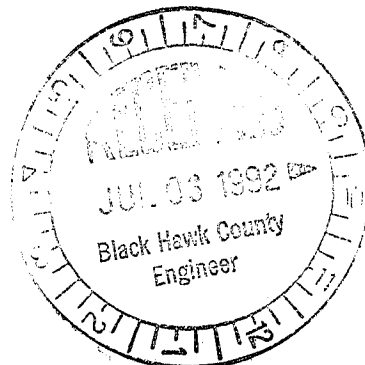

MISC. BK. 301 p. 930

SEAL

