


OF

(Show reason for preparing this certificate, the evidence and detailed procedures used in establishing the corner positions and monumentation found or placed.)


WPA TIE TO NEW COR IS 2641.5' (CURRINO 1939) - CURRENT EDM DIST = 2637.8'

(Show a minimum of three reference ties to durable physical objects, relevant monuments and physical conditions that will enable recovery of the corner.)

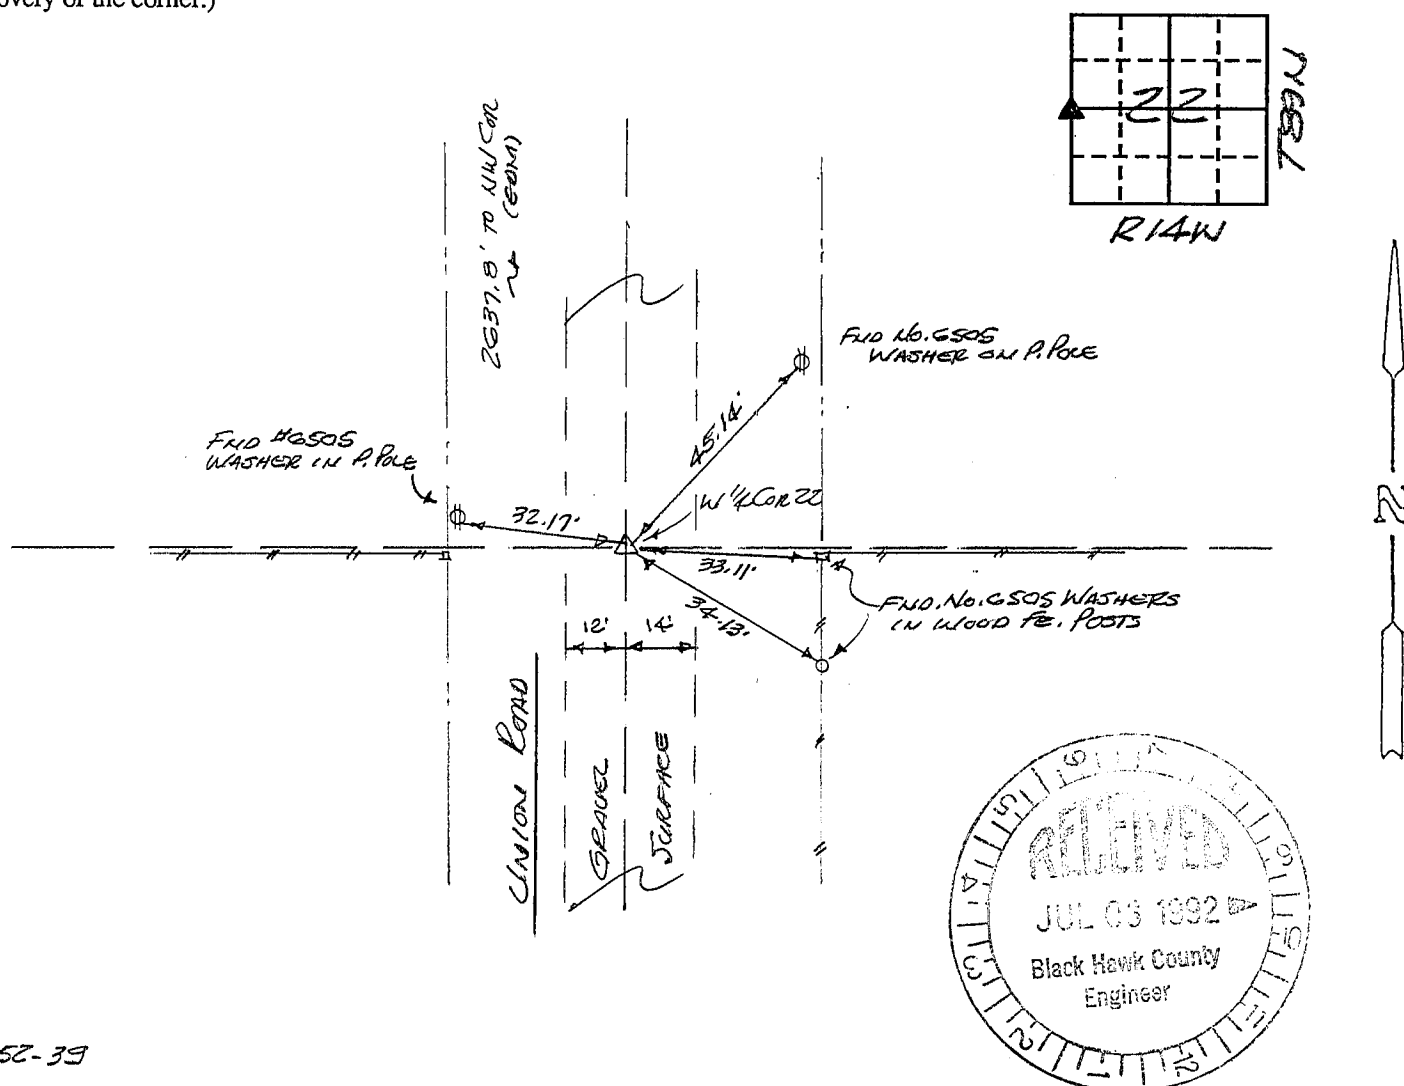

Date: 6-23-1992 Reg. No. 8033

Ely 21 89 N 14 W

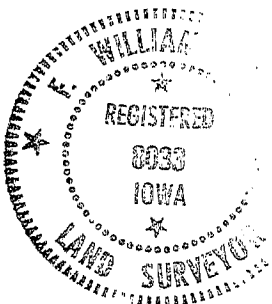

MISC. BK. 301 p. 928