

Recorded

SLSI 9-90

UNITED STATES PUBLIC LAND SURVEY CORNER CERTIFICATE

OF

Land Survey Monuments situated in Section 23, Township T89N, Range R14W, of the Fifth Principal Meridian, BLACK HAWK County, Iowa.
Previously recorded in _____ in County Recorder's Office.



(book, page, document number, etc.)
Now reason for preparing this certificate, the evidence and detailed procedures used in establishing the corner positions and monumentation found or placed.)

Monument Description and Remarks: (NO RECORDS ON FILE)
SW CORNER - SE 1/4 - NW 1/4 - FOUND IRON PIN # 3641 IN FENCE

CENTER - FOUND IRON PIN IN MONUMENT BOX SET
IN PAVING OF NORTH BOUND LANE OF HUDSON ROAD
JUST SOUTH OF BRIDGE

PLAN - VIEW

(Show a minimum of three reference ties to durable physical objects, relevant monuments and physical conditions that will enable recovery of the corner.)

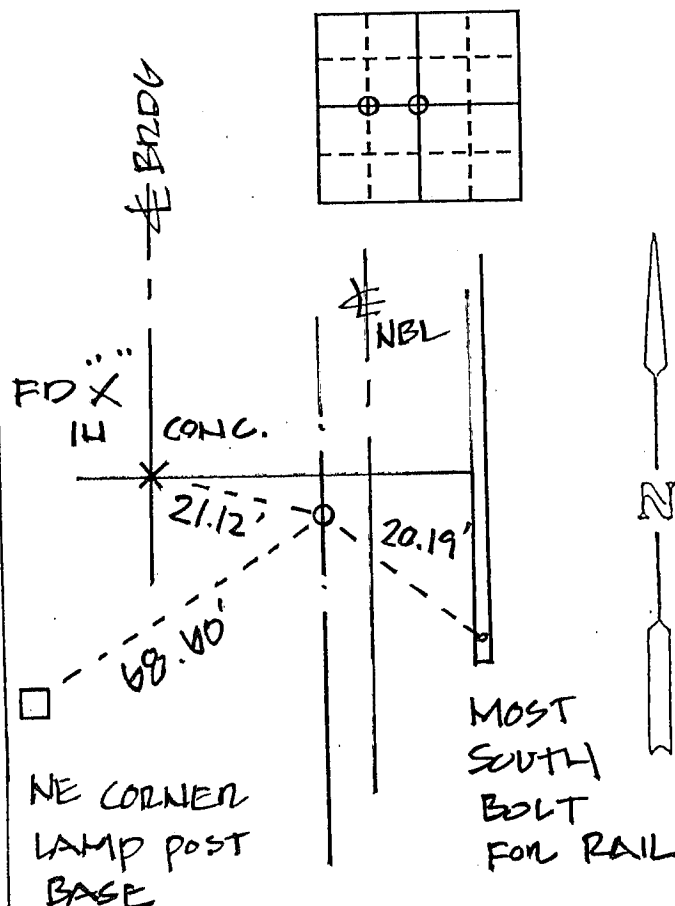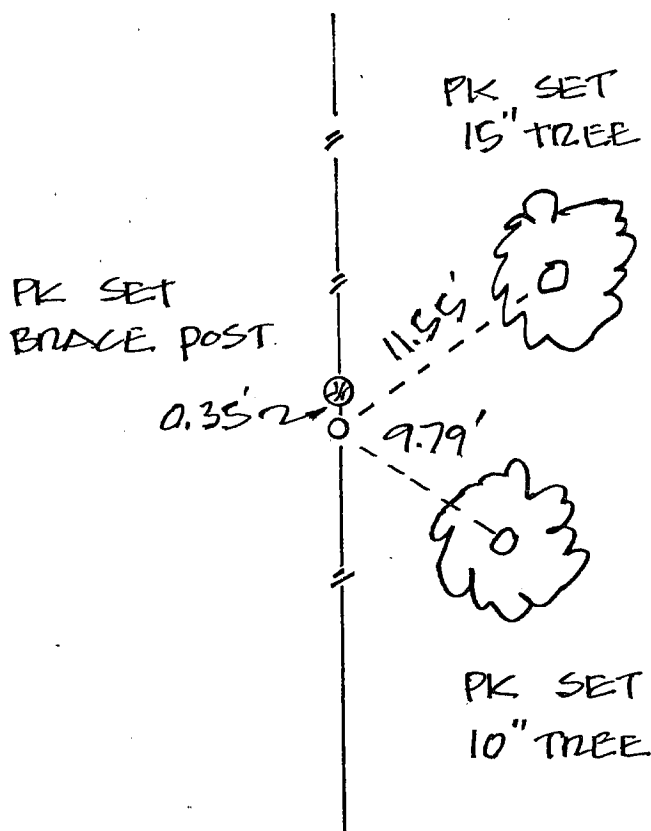


SW COR. SE 1/4 - NW 1/4

CENTER

I hereby certify that the survey work was completed and this certificate was prepared by me or under my direct personal supervision and that I am a duly registered land surveyor under the laws of the state of Iowa.

Signature: GARY W. WHITACRE
Name typed or printed: GARY W. WHITACRE

Date: 2.25.91 Reg. No. LS 10316

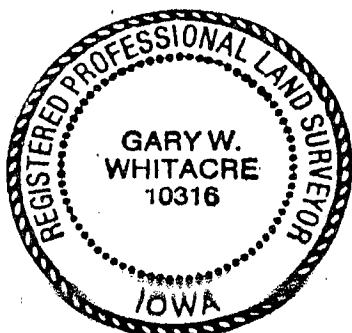

SEAL

Corners	List Corners to be Indexed	Section	Twp	Range
CTR		23	T89N	R14W
SW COR		23	T89N	R14W
SE - NW		23	T89N	R14W

MISC. BK. 294 p. 700