

# INDEX LEGEND

County: BLACK HAWK

Section(s): 23
Township: 89
Range: 14

Aliquot Part(s):

City: CEDAR FALLS

Subdivision:

Block:

Lot:

Owner/Proprietor: CITY OF CEDAR FALLS

Requested by: CITY OF CEDAR FALLS

Preparer: R. ALLEN DIETZ, PLS  
CITY OF CEDAR FALLS  
220 CLAY STREET  
CEDAR FALLS, IOWA 50613

Doc ID: 008233320001
Type: GEN
Recorded: 09/20/2017 at 10:35:13 AM
Fee Amt: \$7.00
Page 1 of 1
Black Hawk County Iowa
SANDIE L. SMITH RECORDER

File
2018-00005054

FOR RECORDER'S USE

## UNITED STATES PUBLIC LAND SURVEY CORNER CERTIFICATE OF

Land Survey Monuments situated in Section No. 23, Township No. 89 North, Range No. 14 West, of the Fifth Principal Meridian, Black Hawk County, Iowa.  
Previously recorded in Book 201200000082 in the office of the County Recorder.  
(book, page, document number, etc.)


(Show reason for preparing this certificate, the evidence and detailed procedures used in establishing the corner positions and monumentation found or placed.)

Monument Description and Remarks: Found 2" aluminum disk in concrete pavement.

Reset Mag-nail from project coordinates and reference ties after asphalt overlay.

### PLAN - VIEW

(Show a minimum of three reference ties to durable physical objects, relevant monuments and physical conditions that will enable recovery of the corner.)

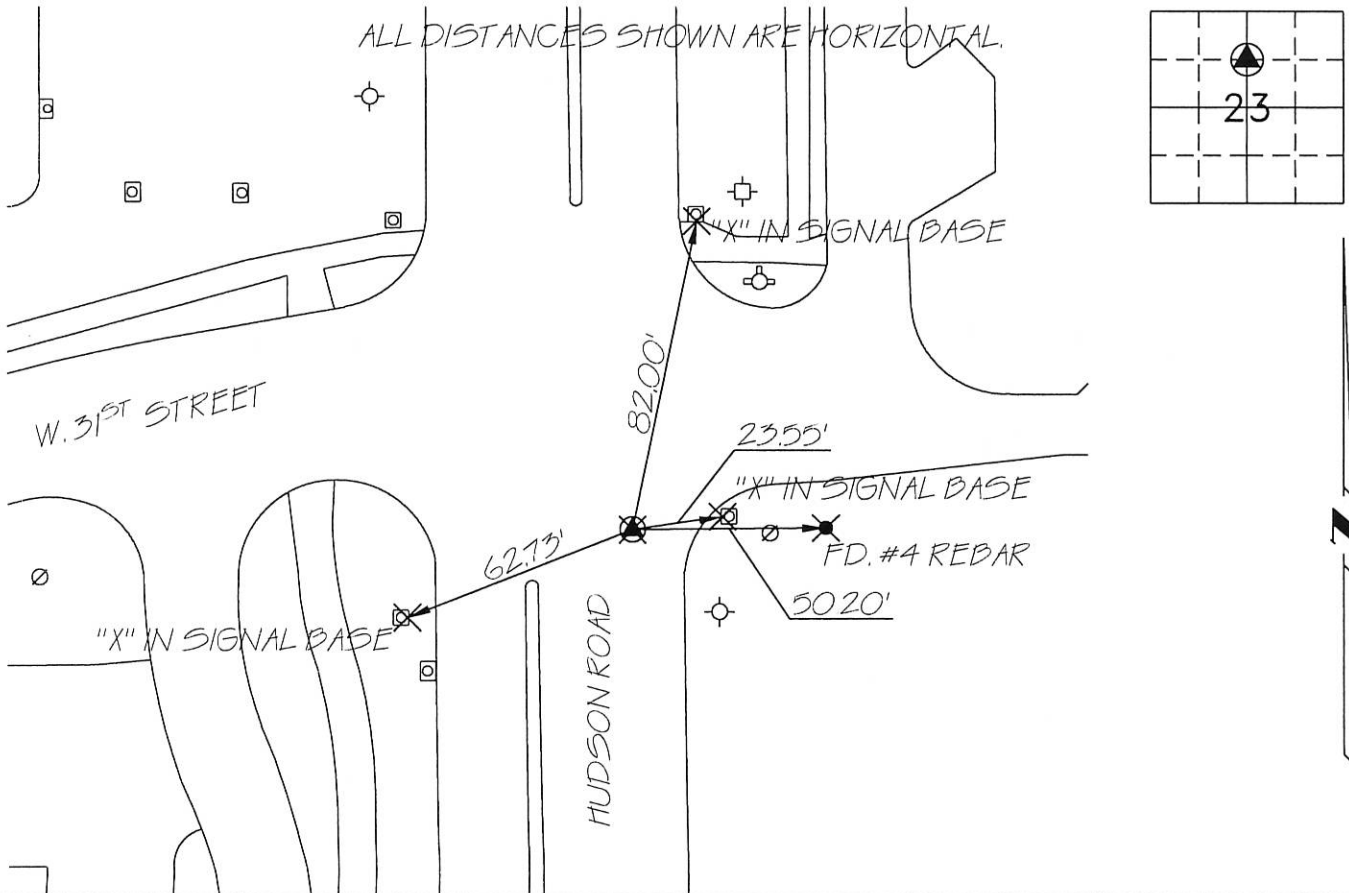

I hereby certify that this land surveying document was prepared by me or under my direct personal supervision and that I am a duly licensed Professional Land Surveyor under the laws of the State of Iowa.

Signed: R. Allen Dietz, P.L.S. Iowa License No. 12086

Date: Sept 15, 2017

SEAL



My License renewal date is December 31, 2018.  
Pages or sheets covered by this seal : this page only

Corners	List Corners to be Indexed	Section	Twp	Range
C N 1/16	23	T89N	R14W	

Drawn by : RAD

Checked by : RAD