



Doc ID: 012065040001 Type: GEN
Recorded: 01/26/2024 at 09:25:11 AM
Fee Amt: \$7.00 Page 1 of 1
Black Hawk County Iowa
SANDIE L. SMITH RECORDER

File 2024-00009349

Michael R. Fagle, P.L.S. AECOM, 501 Sycamore St., Suite 222, Waterloo, Iowa 50703 I-319-232-6531


UNITED STATES PUBLIC LAND SURVEY CORNER CERTIFICATE
OF

Land Survey Monuments situated in Section 23, Township 89,
Range 14W, of the Fifth Principal Meridian, Black Hawk
County, Iowa. Previously recorded in File 2016-00011934
in County Recorder's Office. (Book, Page, Document Number, etc.)

(Show reason for preparing this certificate, the evidence and detailed procedures used in establishing the corner positions and monumentation found or placed.)

Monument Description and Remarks: A cut "X" was found from existing ties during the design survey for the
Reconstruction of W. 27th Street City of Cedar Falls Project No. RC-000-32401. When construction was completed
the corner was reset (Cut "X") and retied.

PLAN - VIEW

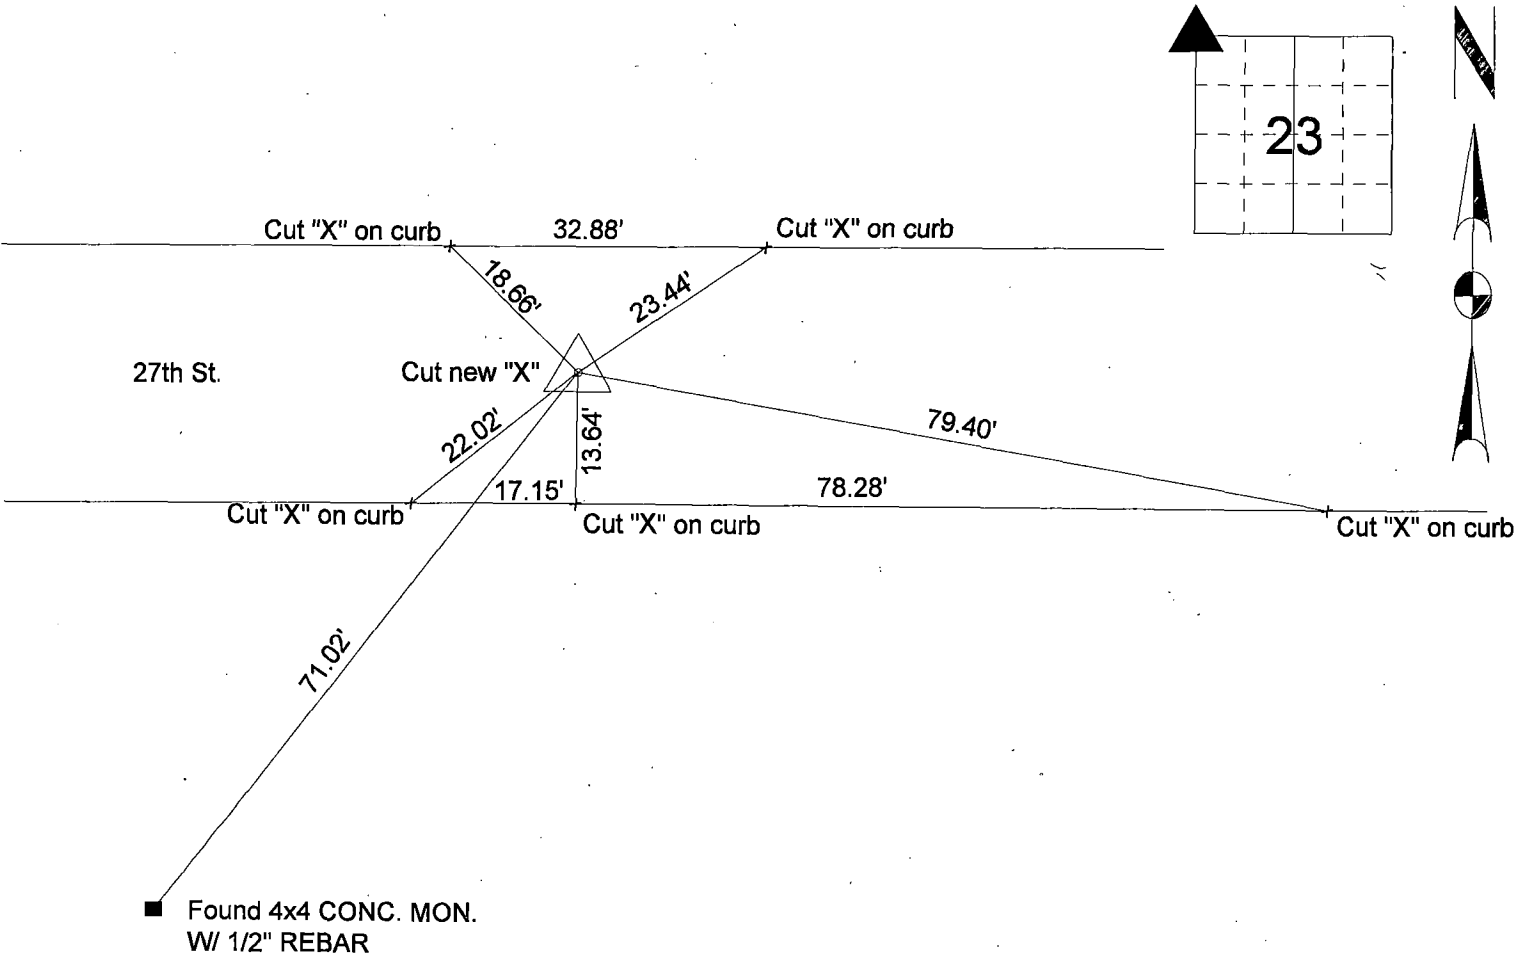

	<p>I hereby certify that this Land Surveying document was prepared by me or under my direct personal supervision and that I am a duly Licensed Land Surveyor under the laws of the State of Iowa.</p> <p><i>Michael R. Fagle</i> 1-25-2024 MICHAEL R. FAGLE Date</p> <p>License number 8505</p> <p>My license renewal date is December 31, 2024</p> <p>Pages or sheets covered by this seal: THIS SHEET</p>	<p>List Corners to be Indexed</p> <table><tr><th>Corners</th><th>Section</th><th>Twp</th><th>Range</th></tr><tr><td>NW</td><td>23</td><td>89</td><td>14W</td></tr></table>	Corners	Section	Twp	Range	NW	23	89	14W
Corners	Section	Twp	Range							
NW	23	89	14W							