
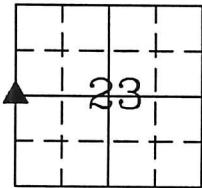


PREPARED BY AND RETURN TO: GREGG E. SAMPSON, AMENT DESIGN, 625 - 32ND AVENUE SW, CEDAR RAPIDS, IA 52404 (319) 378-1401

UNITED STATES PUBLIC LAND SURVEY CORNER CERTIFICATE  
OF

Land Survey Monuments situated in Section 23 Township 89 Range  
14W of the Fifth Principal Meridian Blackhawk County, Iowa.  
Previously recorded in \_\_\_\_\_ in the County Recorder's Office.  
Monument Description and Remarks: Fd. 1/2" rebar illegible cap matching corner certificate Vol. 301  
Page 921. Filing certificate due to certificate on file no longer valid.

PLAN - VIEW

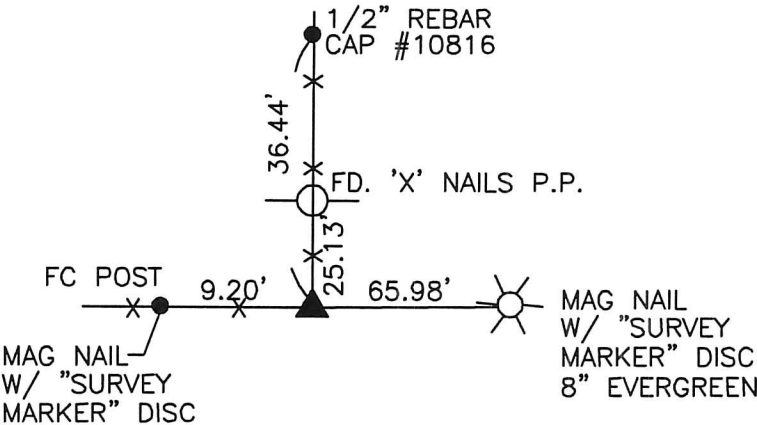

I hereby certify that the survey work was completed and this certificate was prepared by me or under my direct personal supervision and that I am a duly licensed land surveyor under the laws of the state of Iowa.

Signature: Gregg E. Sampson  
Gregg E. Sampson, Iowa Licensed Land Surveyor No. 14809

Date: 12/17/15 License renewal December 31, 2016

List Corners to be Indexed

Corners	Section	Twp	Range
W1/4	23	89	14W

