ΙW

Document Number: 2009010330

Nov 24, 2008 3:55:57 pm Date:

0.00 Aud Fee:

Rec Fee: Rec Management Fee:

Trans Tax: E-Com Fee: 0.00


Non-Standard Page Fee:

1.00 0.00

 \mathbf{Z}

1.00 Filed for record in Black Hawk County, Iowa Judith A. McCarthy, County Recorder

Jeffrey P. Helland, 1107 Technology Parkway, Cedar Falls, lowa 50613-6951, (319)-266-0161 UNITED STATES PUBLIC LAND SURVEY CORNER CERTIFICATE LAND SURVEY MONUMENTS SITUATED IN SECTION NO. 25 _, TOWNSHIP NO. 89_NORTH, RANGE _WEST OF THE FIFTH PRINCIPAL MERIDIAN,_ BLACK HAWK PREVIOUSLY RECORDED IN (SHOW REASON FOR PREPARING THIS CERTIFICATE, THE EVIDENCE AND DETAILED PROCEDURES USED IN ESTABLISHING THE CORNER POSITIONS AND MONUMENTATION FOUND OR PLACED.) MONUMENT DESCRIPTION AND REMARKS: NO USPLSCC ON FILE. SURVEY COMPLETED IN THE SE 1/4 NW 1/4 OF SEC. 25-T89N-R14W. NE CORNER OF SE 1/4 NW 1/4: NO BLACK HAWK COUNTY ENGINEER REFERENCE TIES AVAILABLE. PLAT OF SURVEY BY HAROLD M. JENSEN DATED 5/10/1976 IN 215 MISC. 960 INDICATES CORNER IS 1322.7' SOUTH OF THE N 1/4 CORNER. ESTABLISHED CORNER ON STRAIGHT LINE BETWEEN THE CENTER AND THE N 1/4 CORNER AT A DISTANCE 121.0' NORTH OF THE SE CORNER OF THE N 121' OF THE E 361' OF THE S 1/2 NW 1/4. SET "MAG" NAIL IN P.C.C. PAVEMENT AT CORNER. PLAN VIEW (SHOW A MINIMUM OF THREE REFERENCE TIES TO DURABLE PHYSICAL OBJECTS, RELEVANT MONUMENTS AND PHYSICAL CONDITIONS THAT WILL ENABLE RECOVERY OF THE CORNER.) N 1/4 CORNER SEC. 25-T89N-R14W FOUND "X" CUT IN P.C.C. PAVEMENT (1322.58'), (1322.7')§ 25

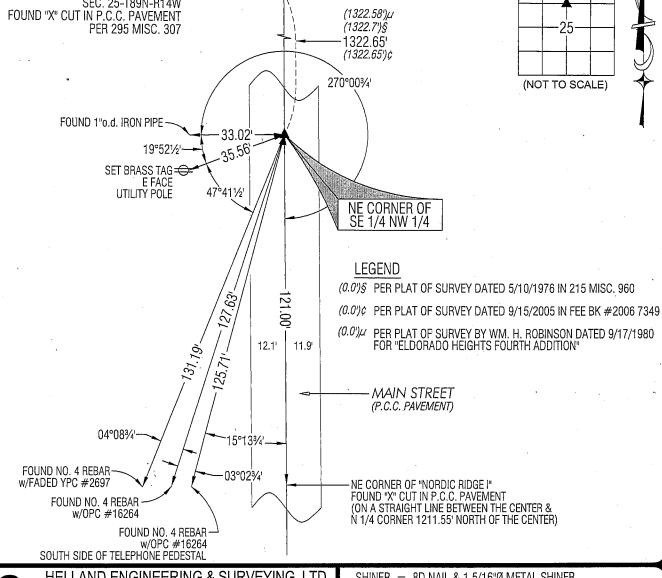

LAND

JEFFREY P

HELLAND 16264

AWO \

SUP

HELLAND ENGINEERING & SURVEYING, LTD

1107 Technology Parkway Cedar Falls, Iowa 50613-6951

(319)-266-0161

I hereby certify that this land surveying document was prepared and the related survey work was performed by me or under my direct personal supervision and that I am a duly licensed Land Surveyor under the laws of the State of lowa.

Welland

11/13/08

Jeffrey P Helland License Number 16264

My license renewal date is December 31, 2009. All pages or sheets are covered by this seal except:

SHINER = 8D NAIL & 1 5/16 METAL SHINER BRASS TAG = 13/16"Ø BRASS TAG w/#16264 OPC = PLASTIC CAP (O=ORANGE, R=RED, Y=YELLOW) (00') RECORDED AS FILE NAME: 08-331C1.DWG

LIST CORNERS TO BE INDEXED SECTION TOWNSHIP

CORNER RANGE 15W **NE CORNER** 25 89N SE 1/4 NW 1/4

Rica