

SC  
MISC  
INDEX 11  
MARGIN  
PROOF  
COMPARE

BLACK HAWK COUNTY IOWA:SS 474  
FILED FOR RECORD JULY 6, 1999 AT  
4:00 P. M. AND RECORDED IN BOOK 334  
OF MISC PAGE 996 .  
*Patricia A. Lass*  
RECORDER  
FEE 1-5.00/  
CITY OF CEDAR FALLS

R. Allen Dietz, L.S. for the City of Cedar Falls  
217 Washington Street Cedar Falls, Iowa 50613 Ph. (319) 273-8606

## UNITED STATES PUBLIC LAND SURVEY CORNER CERTIFICATE OF


Land Survey Monuments situated in Section No. 26, Township No. 89 North, Range  
No. 14 West, of the Fifth Principal Meridian, Black Hawk County, Iowa.  
Previously recorded in Book N/A on Page N/A in the office of the County Recorder.  
(book, page, document number, etc.)

(Show reason for preparing this certificate, the evidence and detailed procedures used in establishing the corner positions and monumentation found or placed.)

Monument Description and Remarks: Found 18"± diameter granite boulder  
approximately 18" deep at toe of high bank South Branch of Dry Run Creek.  
Set 1/2" rebar with plastic registration cap on West bank of South Branch Dry Run  
Creek over stone.

### PLAN - VIEW

(Show a minimum of three reference ties to durable physical objects, relevant monuments and physical conditions that will enable recovery of the corner.)

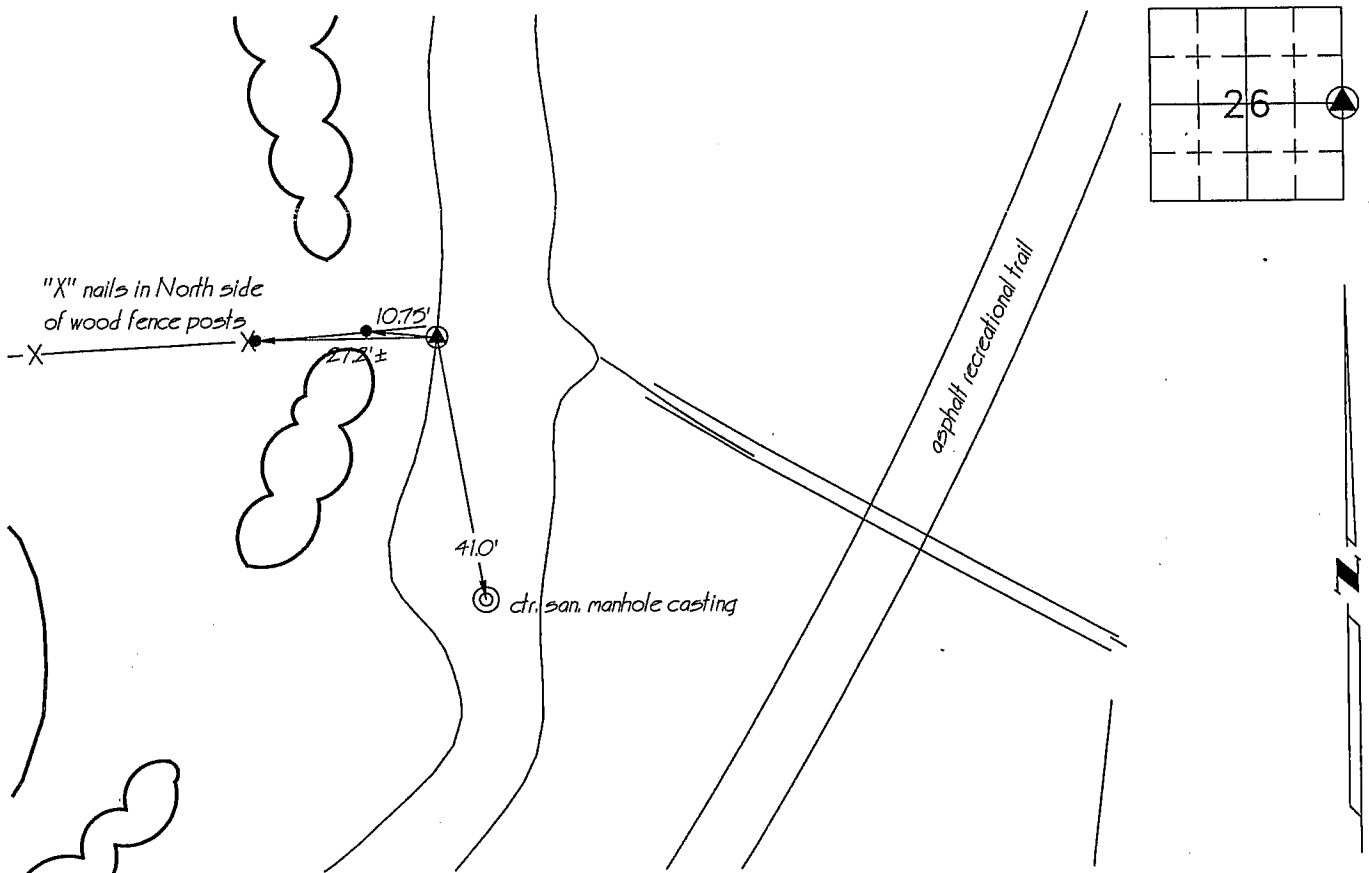

I hereby certify that this land surveying document was prepared by me or under my direct personal supervision and that I am a duly licensed Professional Land Surveyor under the laws of the State of Iowa.

Signed: *R. Allen Dietz*  
R. Allen Dietz Iowa License No. 12086

Date: 1 July  
SEAL  
R. ALLEN  
DIETZ  
12086  
1999

Corners	List Corners to be Indexed Section	Twp	Range
E 1/4 cor.	26	89	14

334 PAGE 996

My License renewal date is December 31, 2000.  
Pages or sheets covered by this seal : this page only

Drawn by : RAD

Checked by : RR