

EXHIBIT
BK I A II
11-29-95

SLSI 9-90

UNITED STATES PUBLIC LAND SURVEY CORNER CERTIFICATE

OF


Land Survey Monuments situated in Section 26
23, Township 89N, Range
R14W, of the Fifth Principal Meridian, BLACK HAWK County, Iowa.
Previously recorded in N/A in County Recorder's Office.

(Show reason for preparing this certificate, the evidence and detailed procedures used in establishing the corner positions and monumentation found or placed.)

Monument Description and Remarks: FOUND #2697 CAPPED PIN IN MONUMENT PAINTED BOX
IN SOUTH BOUND LANE HUDSON ROAD PER CITY CEDAR FALLS ENGR DEPT.

PLAN - VIEW

(Show a minimum of three reference ties to durable physical objects, relevant monuments and physical conditions that will enable recovery of the corner.)

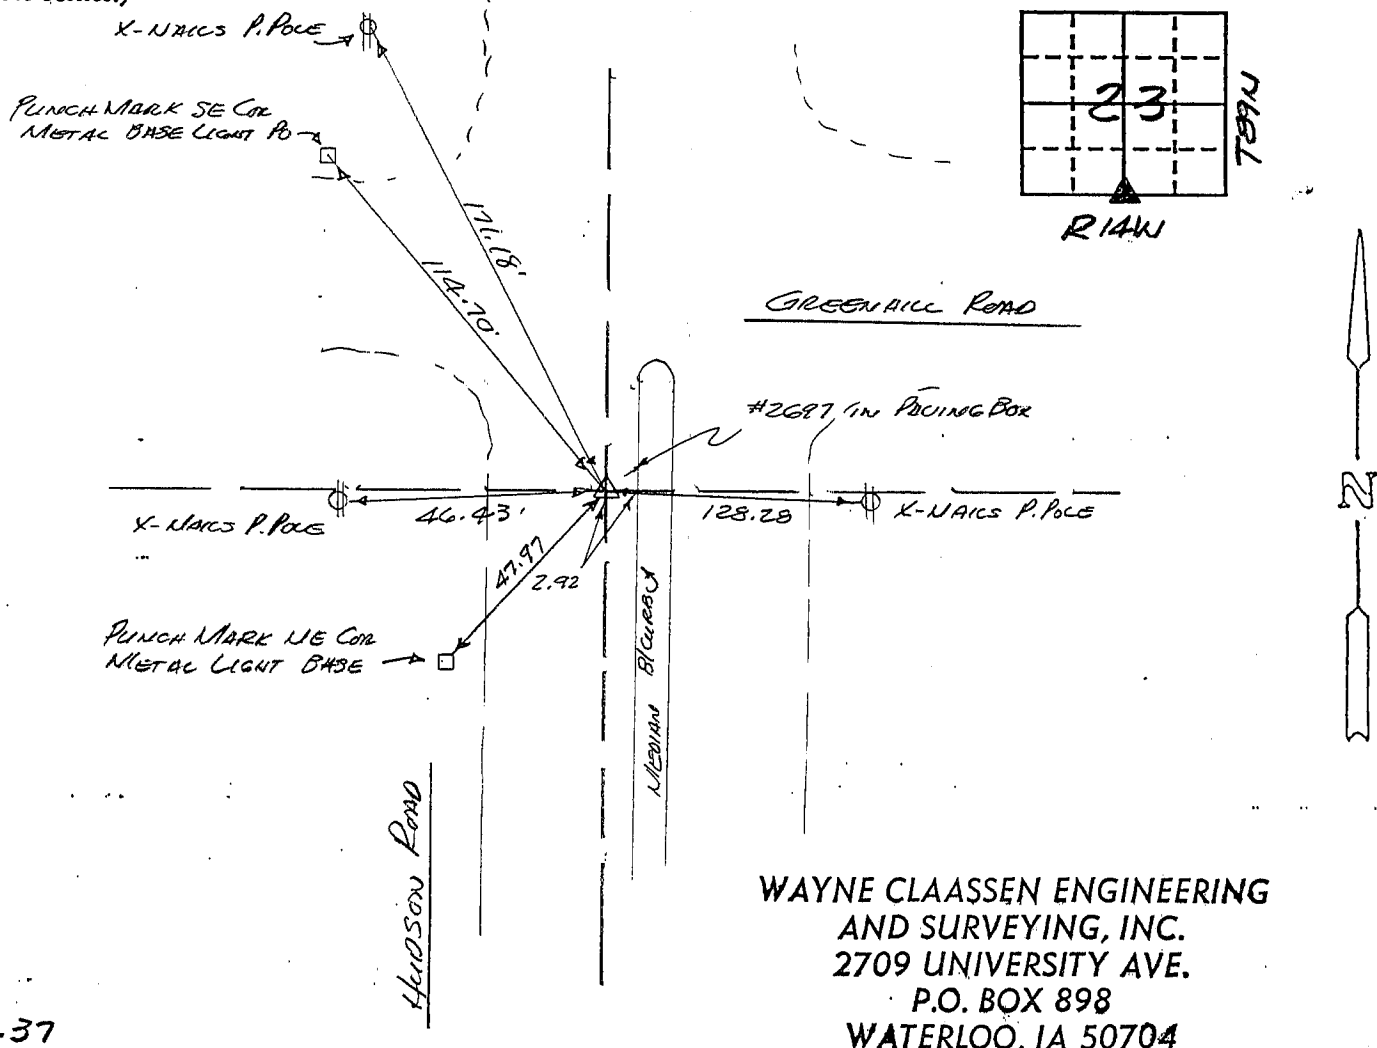

I hereby certify that the survey work was completed and this certificate was prepared by me or under my direct personal supervision and that I am a duly registered land surveyor under the laws of the state of Iowa.

Signature: F. William King
Name typed or printed: F. WILLIAM KING
Date: MAY 8, 1995 Reg. No. 8033

Corners	List Corners to be Indexed		
	Section	Twp	Range
<u>514</u>	<u>23</u>	<u>89N</u>	<u>14W</u>
<u>N 1/4</u>	<u>26</u>	<u>89</u>	<u>14W</u>



MISC. BK. 315 p. 640