

PRELIMINARY

R. Allen Dietz, L.S. for the City of Cedar Falls  
220 Clay Street Cedar Falls, Iowa 50613 Ph. (319) 273-8606

UNITED STATES PUBLIC LAND SURVEY CORNER CERTIFICATE  
OF


Land Survey Monuments situated in Section No. 27, Township No. 89 North, Range  
No. 14 West, of the Fifth Principal Meridian, Black Hawk County, Iowa.  
Previously recorded in MISC. BK. 336 - p. 106 in the office of the County Recorder.  
(book, page, document number, etc.)

(Show reason for preparing this certificate, the evidence and detailed procedures used in establishing the corner positions and monumentation found or placed.)

Monument Description and Remarks: Found standard concrete monument 18" ± deep at  
the northwest corner of Lot 12, Meadows Second Addition. Set 18" #4 rebar with plastic  
registration cap #12086 over monument.

PLAN - VIEW

(Show a minimum of three reference ties to durable physical objects, relevant monuments and physical conditions that will enable recovery of the corner.)

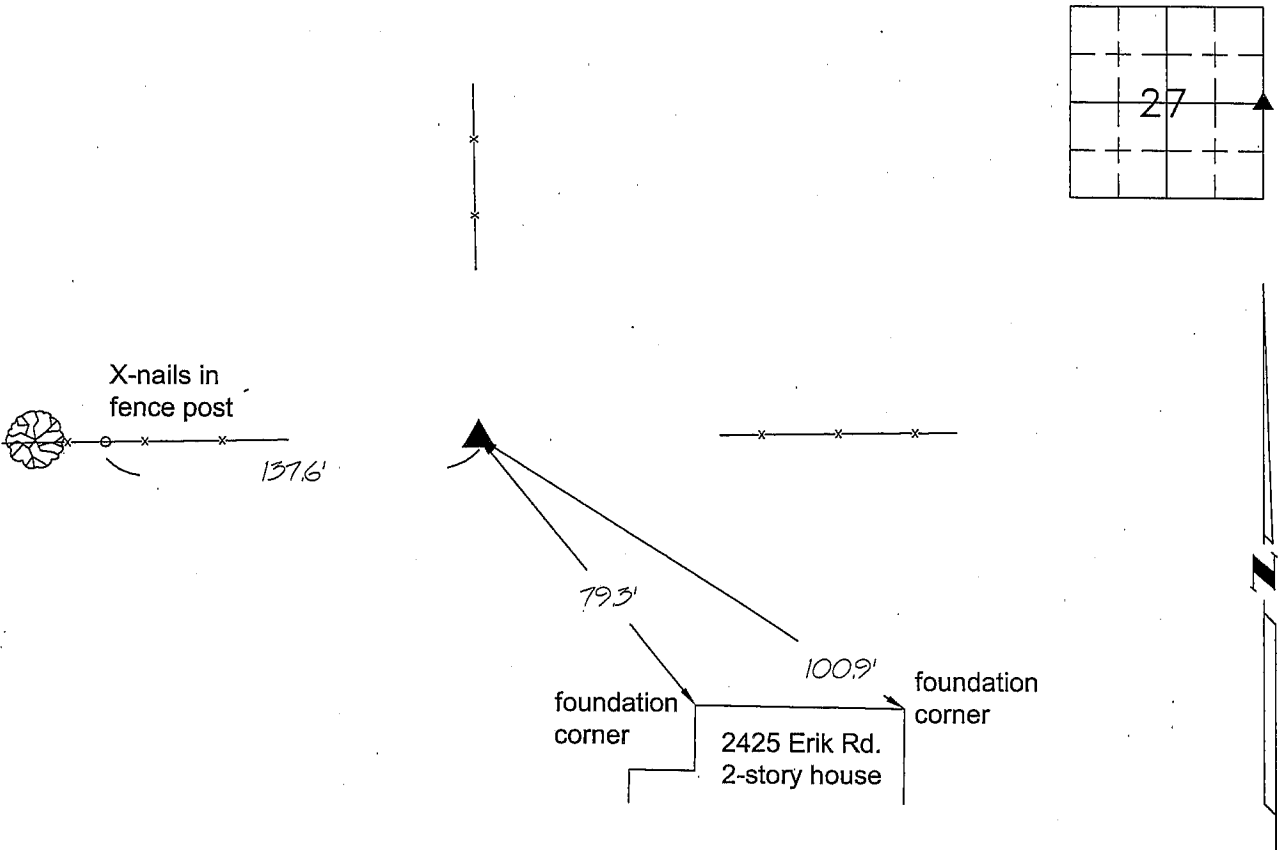


I hereby certify that this land surveying document was prepared by me or under my direct personal supervision and that I am a duly licensed Professional Land Surveyor under the laws of the State of Iowa.

Signed: R. Allen Dietz  
R. Allen Dietz, L.S. Iowa License No. 12086

Date: MAY 5 2007

SEAL

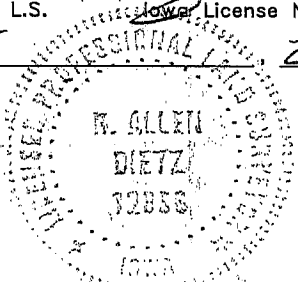

My License renewal date is December 31, 2008.  
Pages or sheets covered by this seal : this page only

Corners	List Corners to be Indexed Section	Indexed Twp	Range
E1/4	27	89	14

Drawn by : RAD

Checked by : JCH