

ENV  
CITY OF CEDAR FALLS  
220 CLAY STREET  
CEDAR FALLS, IA 50613

I  
P  
Z

Document Number: 2007024692  
Date: May 21, 2007 4:30:00 pm  
Aud Fee: 0.00 Rec Fee: \*5.00  
Trans Tax: 0.00 Rec Management Fee: 1.00  
E-Com Fee: 1.00 Non-Standard Page Fee: 0.00  
Filed for record in Black Hawk County, Iowa  
Judith A. McCarthy, County Recorder

R. Allen Dietz, L.S. for the City of Cedar Falls  
220 Clay Street Cedar Falls, Iowa 50613 Ph. (319) 273-8606

UNITED STATES PUBLIC LAND SURVEY CORNER CERTIFICATE  
OF


Land Survey Monuments situated in Section No. 27, Township No. 89 North, Range No. 14 West, of the Fifth Principal Meridian, Black Hawk County, Iowa.  
Previously recorded in \_\_\_\_\_ in the office of the County Recorder.  
(book, page, document number, etc.)

(Show reason for preparing this certificate, the evidence and detailed procedures used in establishing the corner positions and monumentation found or placed.)

Monument Description and Remarks: Found #4 rebar with YPC #3641, 4" deep in line with fences to the north, south, and east.

PLAN - VIEW

(Show a minimum of three reference ties to durable physical objects, relevant monuments and physical conditions that will enable recovery of the corner.)

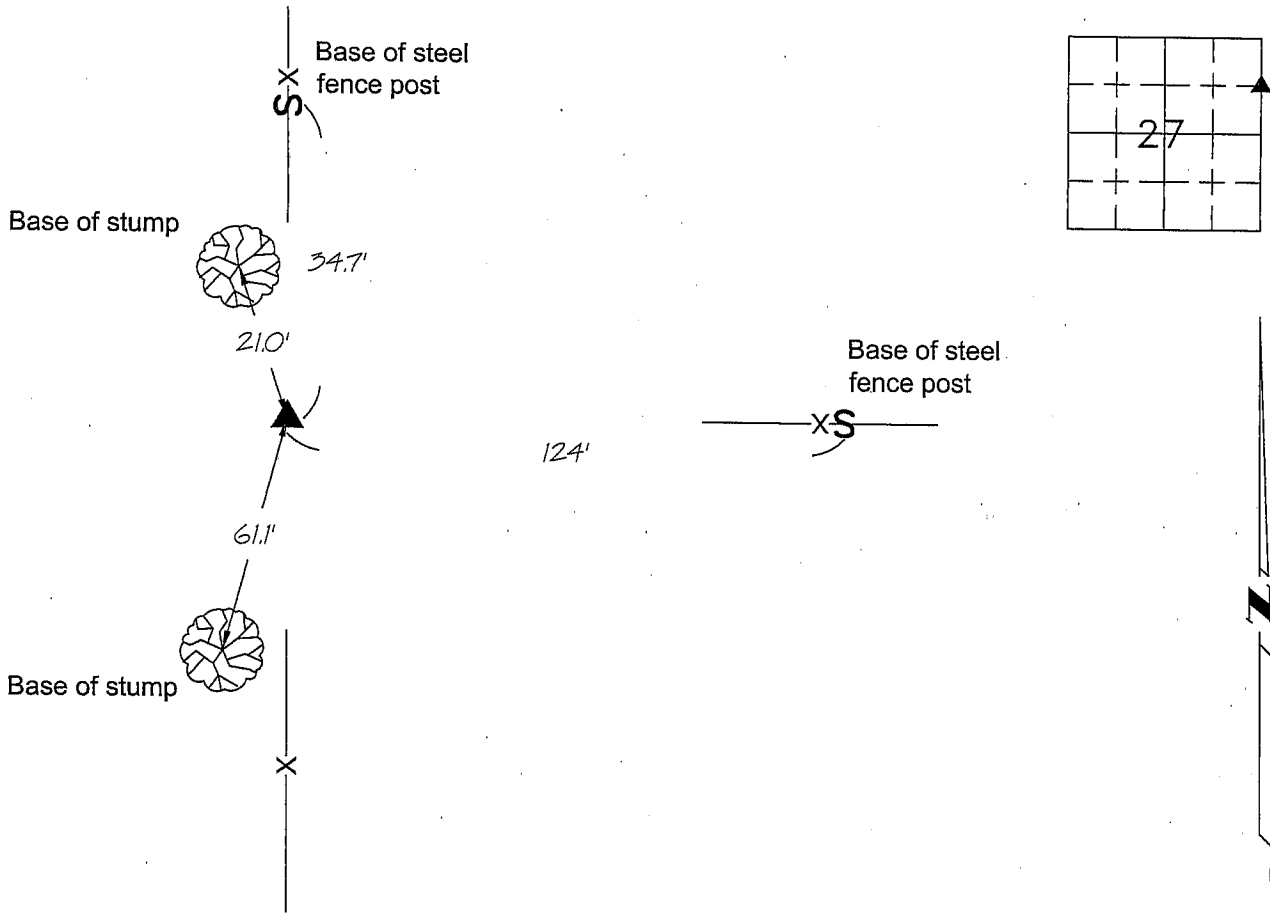


I hereby certify that this land surveying document was prepared by me or under my direct personal supervision and that I am a duly licensed Professional Land Surveyor under the laws of the State of Iowa.

Signed: R. Allen Dietz  
R. Allen Dietz, L.S. Iowa License No. 12086

Date: MAY 17 2007

SEAL

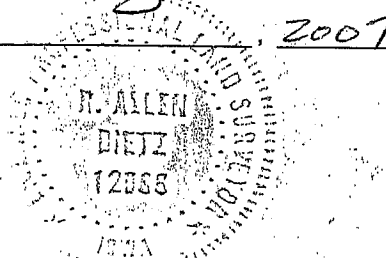

My License renewal date is December 31, 2008.  
Pages or sheets covered by this seal : this page only

List Corners to be Indexed			
Corners	Section	Twp	Range
NE COR SE NE	27	89	14

Drawn by : JCH

Checked by : RAD