

ENV  
CITY OF CEDAR FALLS

INS  
P  
Z

Document Number: 2007023573  
Date: May 08, 2007 4:30:00 pm  
Aud Fee: 0.00 Rec Fee: 5.00  
Trans Tax: 0.00 Rec Management Fee: 1.00  
E-Com Fee: 1.00 Non-Standard Page Fee: 0.00  
Filed for record in Black Hawk County, Iowa  
Judith A. McCarthy, County Recorder

R. Allen Dietz, L.S. for the City of Cedar Falls  
220 Clay Street Cedar Falls, Iowa 50613 Ph. (319) 273-8606

UNITED STATES PUBLIC LAND SURVEY CORNER CERTIFICATE  
OF


Land Survey Monuments situated in Section No. 27, Township No. 89 North, Range No. 14 West, of the Fifth Principal Meridian, Black Hawk County, Iowa.  
Previously recorded in \_\_\_\_\_ in the office of the County Recorder.

(Show reason for preparing this certificate, the evidence and detailed procedures used in establishing the corner positions and monumentation found or placed.)

Monument Description and Remarks: Found broken standard concrete monument in gravel road. Located intact base of monument 4" south of a #4 rebar 12" deep. Reset monument top over base. Top of monument is 3" below road surface.

PLAN - VIEW

(Show a minimum of three reference ties to durable physical objects, relevant monuments and physical conditions that will enable recovery of the corner.)

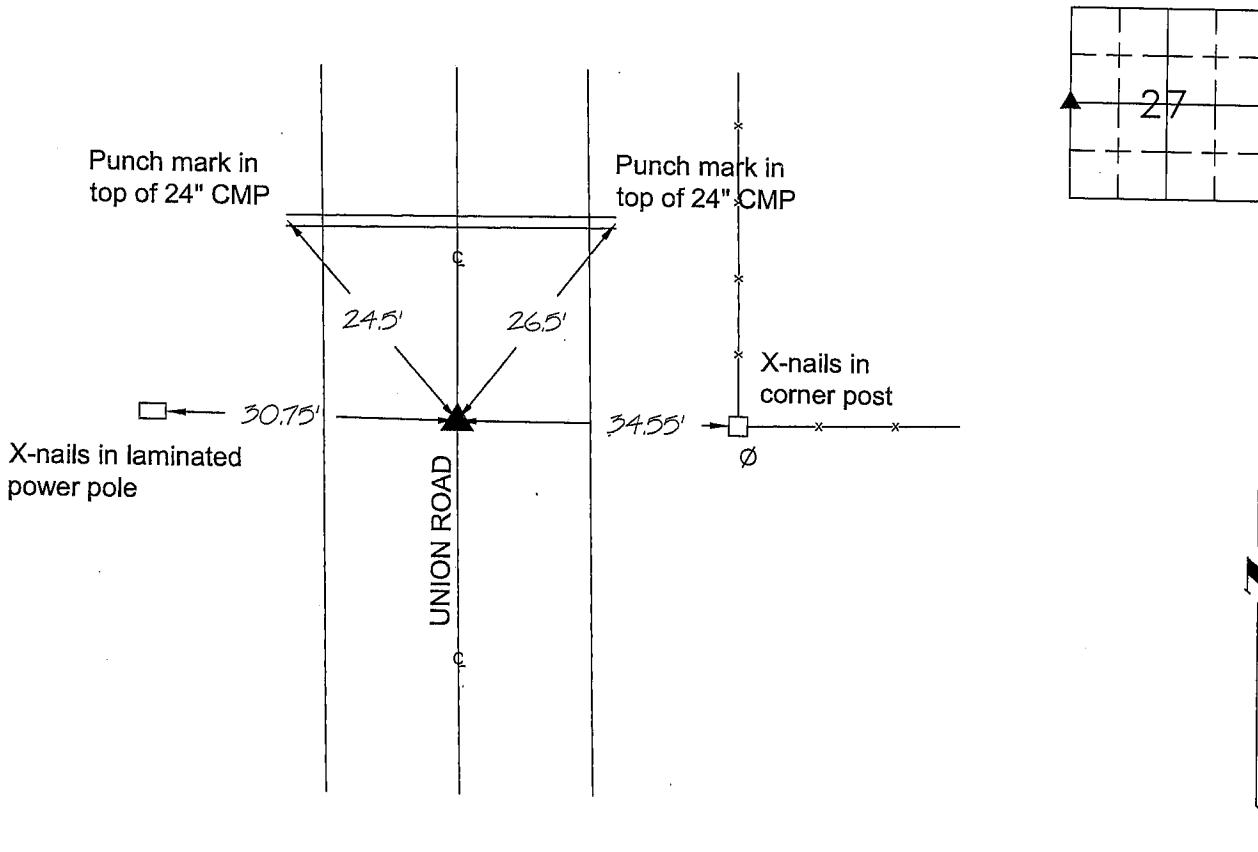

I hereby certify that this land surveying document was prepared by me or under my direct personal supervision and that I am a duly licensed Professional Land Surveyor under the laws of the State of Iowa.

Signed: R. Allen Dietz  
R. Allen Dietz, L.S. Iowa License No. 12086

Date: MAY 5, 2007

SEAL



My License renewal date is December 31, 2008.  
Pages or sheets covered by this seal : this page only

Corners	List Corners to be Indexed Section	Twp	Range
W 1/4	27	89	14

Drawn by : RAD

Checked by : JCH