


BLACK HAWK COUNTY
R 14 W

ENTERED
T 89 N 2-6-45
BKS-88
89



UNITED STATES
PUBLIC LAND SURVEY
CORNER CERTIFICATE
BLACK HAWK COUNTY
GRUNDY COUNTY

SECTION $\frac{31}{1}$ - T $\frac{89}{88}$ N - R $\frac{14}{15}$ W
PROJECT NO. NHSN-520-5(32)--2R

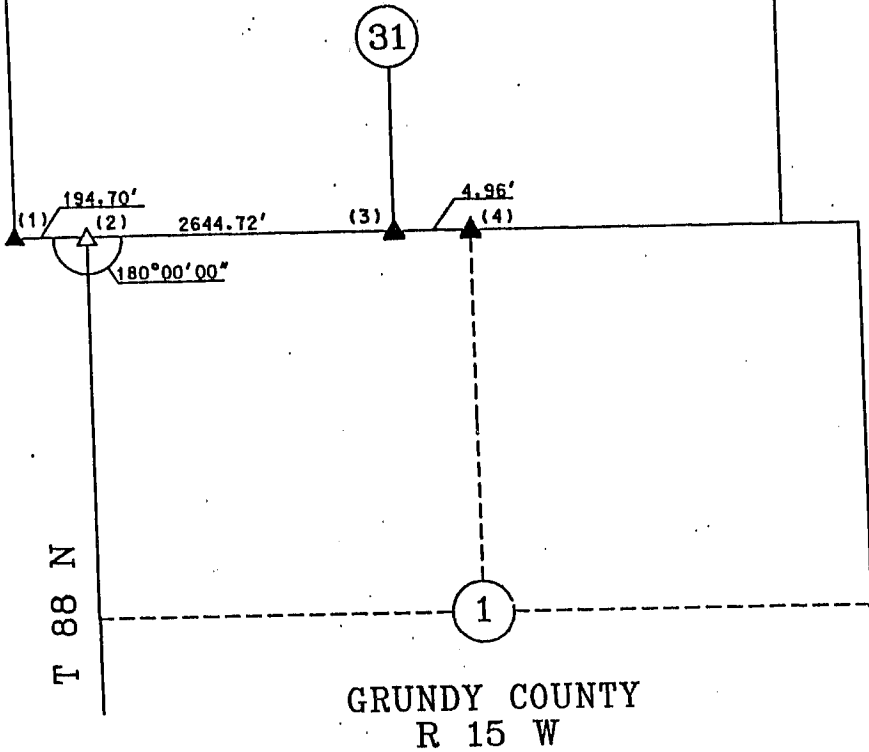


N

MADE FOR
IOWA DEPARTMENT OF TRANSPORTATION
HIGHWAY DIVISION

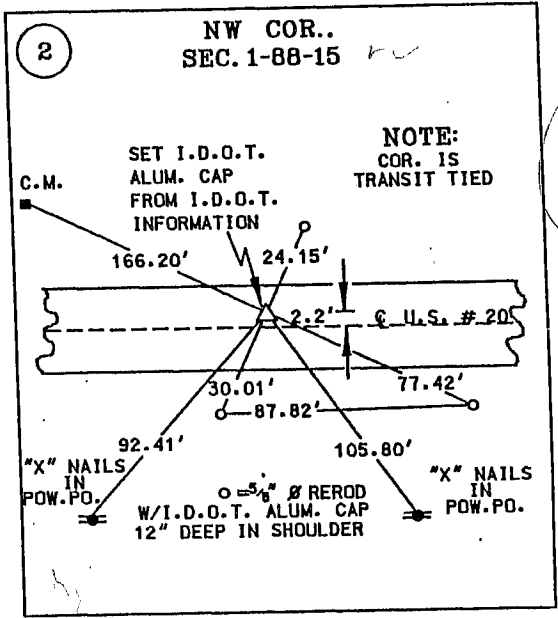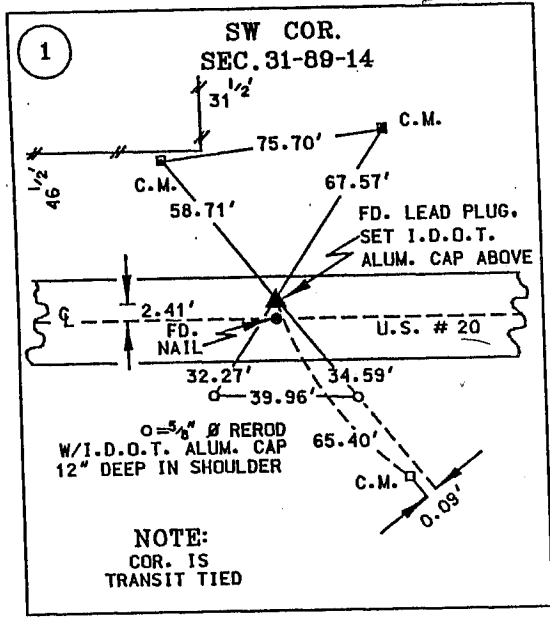

88N 15W
SEC. 2
SEC 1
N 1/4

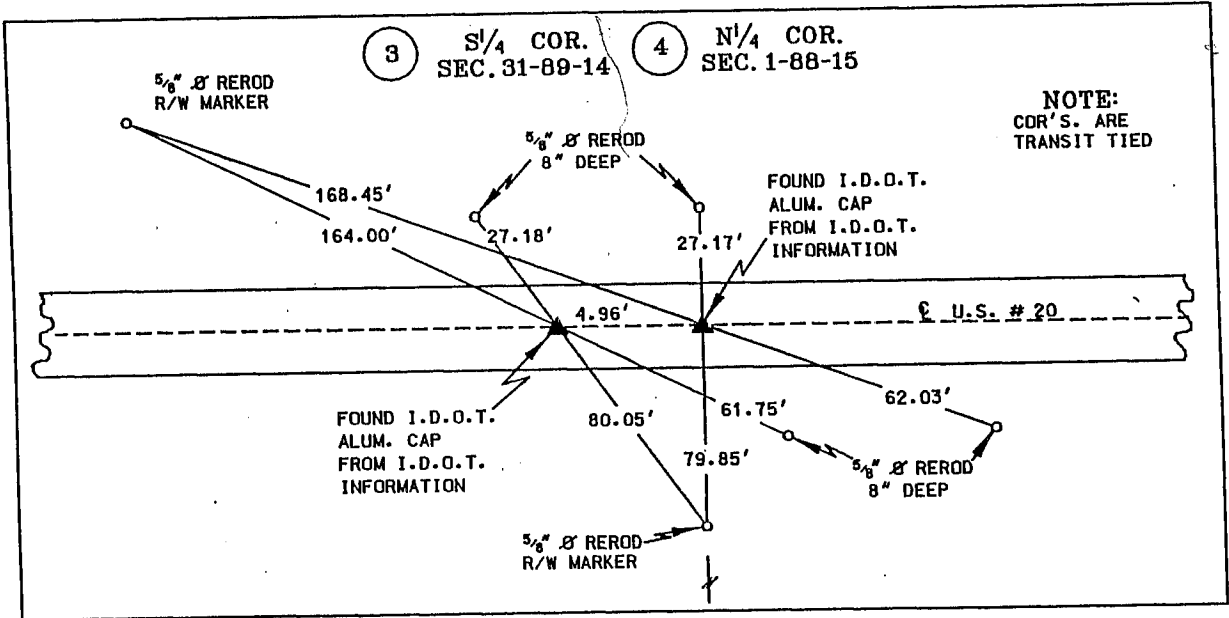

I hereby certify that the survey work was completed and this certificate was prepared by me or under my direct personal supervision and that I am a duly registered land surveyor under the laws of the state of Iowa.

Signature: Norman M. Miller
Norman M. Miller

Date: Dec. 2, 1994 Reg. No. 11421
My registration expires Dec. 31, 1994.



CORNERS TO BE INDEXED			
Corner	Sec.	Twp.	Rge.
SW	31	89N	14W
NW	1	88N	15W
NE	2	88N	15W
S 1/4	31	89N	14W
N 1/4	1	88N	15W