

Doc ID: 003672390001 Type: GEN Recorded: 02/20/2009 at 11:03:56 AM Fee Amt: \$7.00 Page 1 of 1 Instr# 200800017755 Black Hawk County Iowa JUDITH A MCCARTHY RECORDER Book 1080 Page 16696 - 16696 File 2009-00015416


AECOM, 501 Sycamore St., Suite 222, Waterloo, Iowa 50703


UNITED STATES PUBLIC LAND SURVEY CORNER CERTIFICATE OF

Land Survey Monuments situated in	Section 34 Township 89 North
Range 14 West , of the Fifth 1	
County, lowa. Previously recorded in	
in County Recorder's Office.	(Book, Page, Document Number, etc.)
	rtificate, the evidence and detailed procedures itions and monumentation found or placed.)
Monument Description and Remarks:	DURING THE CONSTRUCTION OF TARGET COLD
STORAGE BUILDING THE S.C.M. AT THE E	1/4 CORNER OF SECTION 34-89-14W WAS
DESTROYED. SET I" DIA. PIPE WITH A 1/2"	REBAR WITH A YELLOW PLASTIC CAP NO. 8505 .
1	

PLAN - VIEW

(Show a minimum of three reference ties to durable physical objects, relevant monuments and physical conditions that will enable recovery of the corner.)

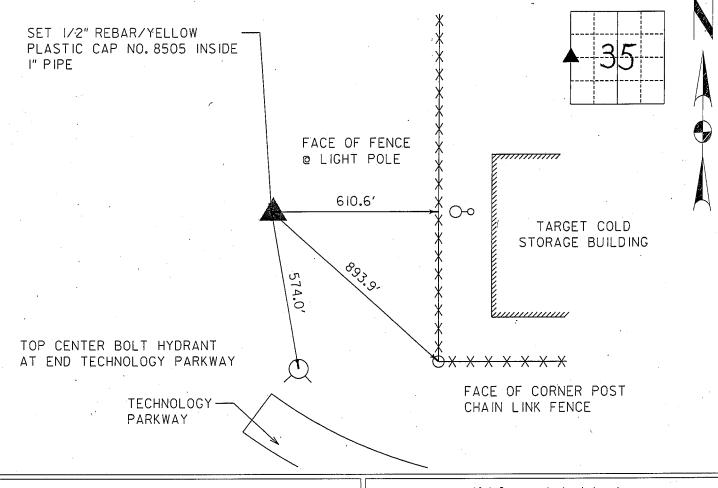

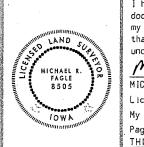

I hereby certify that this Land Surveying document was prepared by me or under my direct personal supervision and that I am a duly Licensed Land Surveyor under the laws of the State of Iowa.

MICHAEL R. FAGLE 1-13-09

My license renewal date is December 31,2010 Pages or sheets covered by this seal:

THIS SHEET

List Corners to be indexed

34 R 14 W EAST CORNER T 89 N