

\*BHC Engineer

Prepared by & Return to: Isaiah M. Reicks, HRS, LLC, 2206 East Bremer Avenue, Waverly, IA 50677, Phone 319-483-5187

United States Public Land Survey Corner Certificate

Land Survey Monument situated in  
Section 34, Township 89 North, Range 14 West of the Fifth Principal Meridian, Black Hawk County, Iowa.  
On file in Document #2009-00021137 in the County Recorder's Office.

This certificate is being prepared in compliance with Iowa Code Chapter 355.11 because: 

There is no certificate on file for this corner.

There are no longer three valid ties of record.

There are changes to reference ties of record.

☒ There is change of monumentation of record.


To clarify description of record monument (ties).

Monument Description and Remarks:

**Southeast Corner:** Previously recorded Section Corner Certificate indicates "Found 5/8"Ø Rebar". Searched for said monument, unable to recover but found a hole in the pavement, therefore computed a position with information from the remaining ties and compared the distances to adjacent section corners. The computed position checked very well. Set 1"Ø Bronze Survey Marker PLS 22468 with the coordinates of the computed position derived prior to highway reconstruction. Corner reset in conjunction with Project No. LFM-5025--7X-07.

Plan View - Not to Scale

(Show a minimum of three reference ties to durable physical objects, relevant monuments and physical conditions that will enable recovery of the corner.)

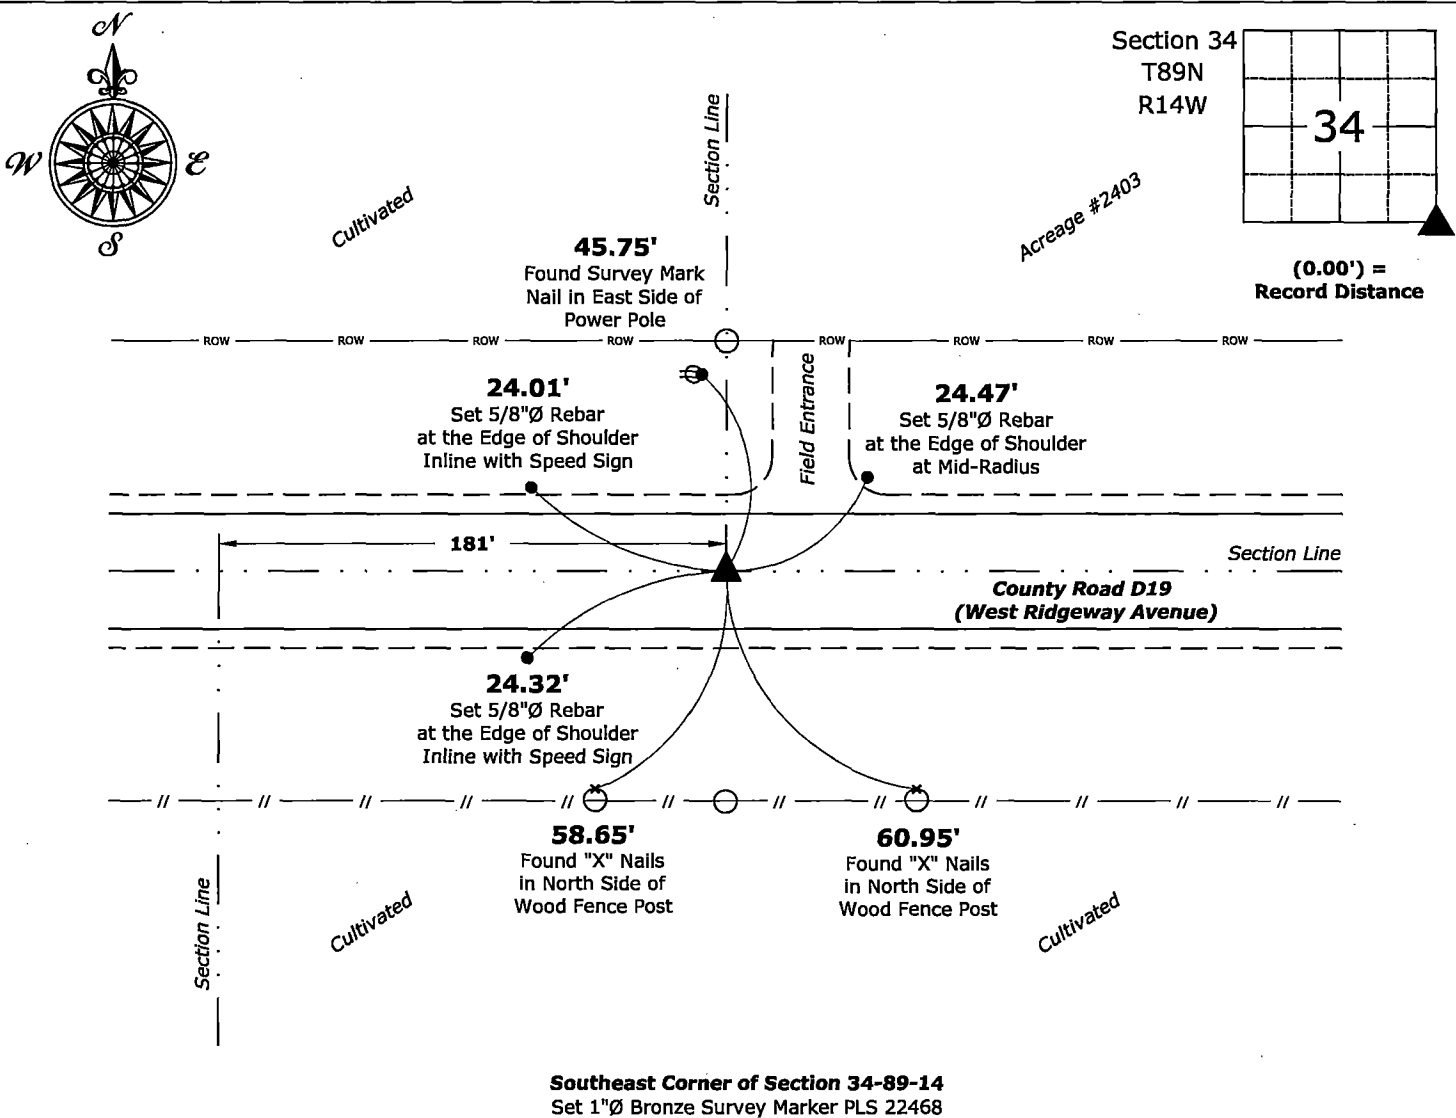

Southeast Corner of Section 34-89-14  
Set 1"Ø Bronze Survey Marker PLS 22468



I hereby certify that this land surveying document was prepared and the related survey work was performed by me or under my direct personal supervision and that I am a duly licensed Land Surveyor under the laws of the State of Iowa.  
*Isaiah M. Reicks* 8-23-23  
Isaiah M. Reicks Date:  
License number 22468  
My license renewal date is December 31, 2023.  
Sheets covered by this seal: Individual sheet only

List Corner to be Indexed			
Corner	Section	Township	Range
SE	34	89	14
Project Number: 2023-533			
FB: Black Hawk 11, Page(s) 11-12			