


File 2017-00002918

UNITED STATES PUBLIC LAND SURVEY CORNER CERTIFICATE
OF

THIS CERTIFICATE WAS PREPARED BECAUSE THESE CORNERS WERE USED DURING A PLAT OF SURVEY IN THE NW 1/4 OF THE SW 1/4 SECTION 34-89-14. CORNERS WERE FOUND USING METHODS DESCRIBED BELOW.

A 4x4 grid with the number 34 in the center. The grid is labeled (R14W) on the left and (T89N) on the right. Arrows point to the left and right from the center cell.

EXISTING FENCE
NAIL WITH SURVEY MARKER

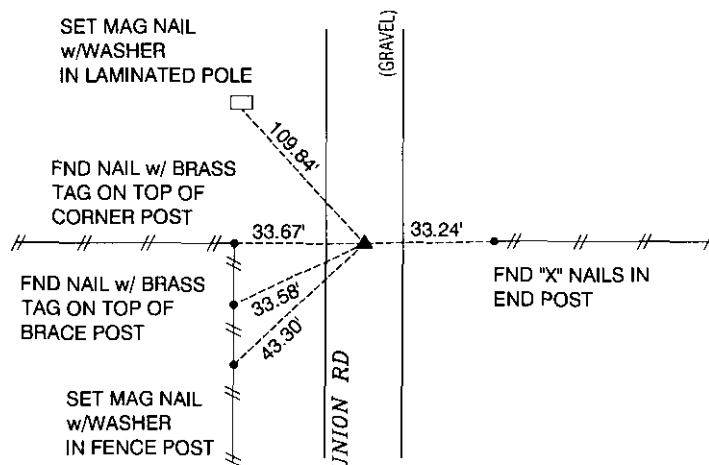

FND CONCRETE MON. w/ DISK
(8" DEEP)
FND 5/8" IP ON NORTH SIDE OF CONCRETE
MON. USED FOR MAGNETIC LOCATION ONLY
USED TIES OBTAINED FROM COUNTY
RECORDS OFFICE

