

Doc ID: 004646480001 Type: GEN  
 Kind: CORNER  
 Recorded: 12/02/2011 at 10:29:45 AM  
 Fee Amt: \$7.00 Page 1 of 1  
 Black Hawk County Iowa  
 JUDITH A MCCARTHY RECORDER  
 File **2012-00010068**

Recorded By: Michael R. Fagle, P.L.S.

AECOM, 501 Sycamore St., Suite 222, Waterloo, Iowa 50703

1-319-232-6531

## UNITED STATES PUBLIC LAND SURVEY CORNER CERTIFICATE OF


Land Survey Monuments situated in Section 35, Township 89 North,  
 Range 14 West, of the Fifth Principal Meridian, Black Hawk  
 County, Iowa. Previously recorded in Document 2007023301  
 in County Engineer's Office. (Book, Page, Document Number, etc.)

(Show reason for preparing this certificate, the evidence and detailed procedures used in establishing the corner positions and monumentation found or placed.)

Monument Description and Remarks: Found Core Hole for Disc, after construction was completed on the City of Cedar Falls Ridgeway Avenue Reconstruction Project (RC-000-1913) a 2" Brass Disc with Magnetic Washer was set.  
 Stamped LS 8505 - 1/4 S 35 - S 3.

### PLAN - VIEW

(Show a minimum of three reference ties to durable physical objects, relevant monuments and physical conditions that will enable recovery of the corner.)

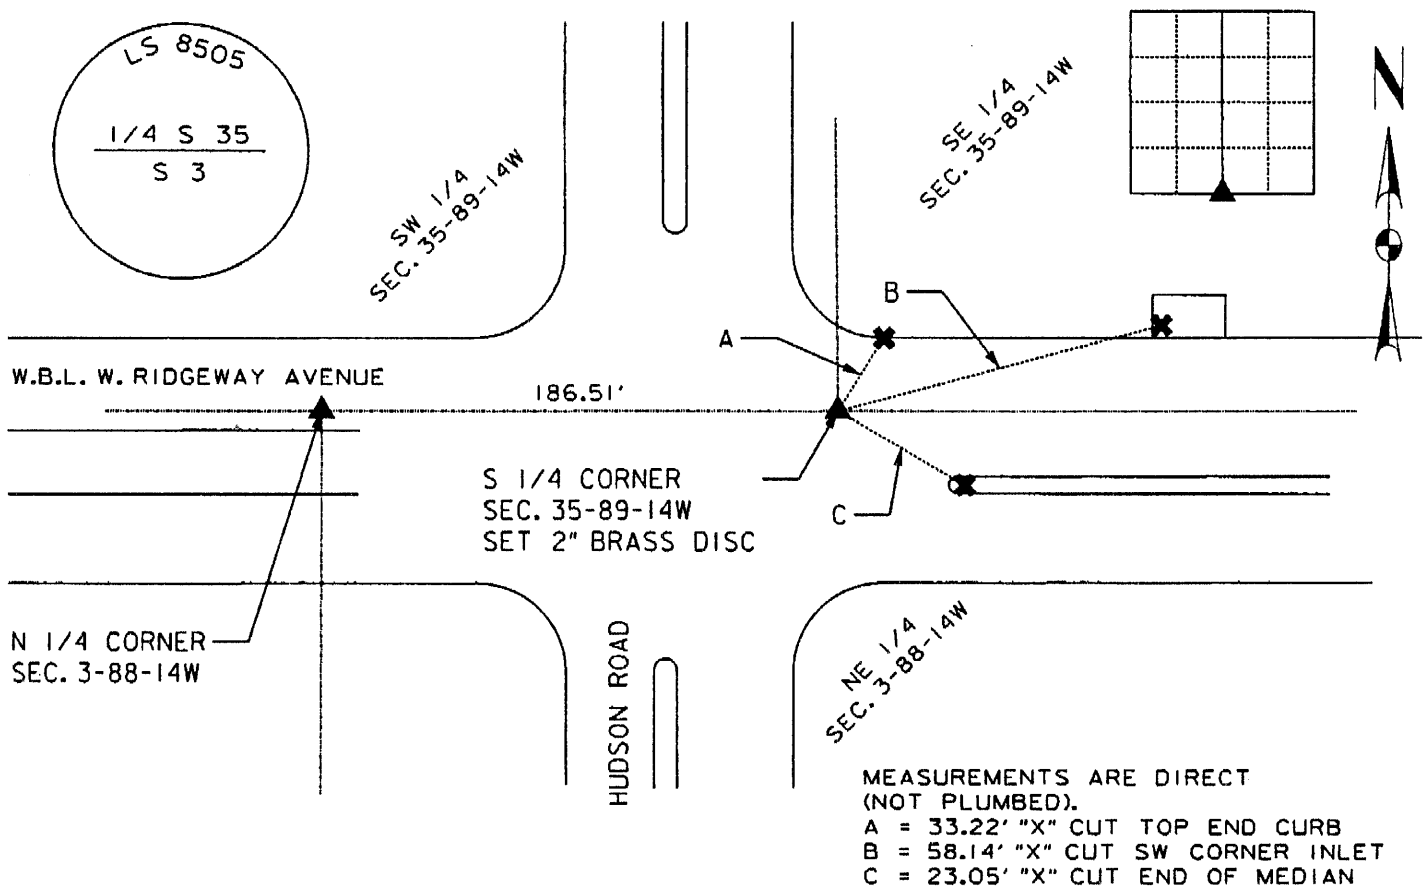

	I hereby certify that this Land Surveying document was prepared by me or under my direct personal supervision and that I am a duly Licensed Land Surveyor under the laws of the State of Iowa.	
	<i>Michael R. Fagle</i>	12-01-2011
	MICHAEL R. FAGLE	Date
	License number 8505	
	My license renewal date is December 31, 2012	
Pages or sheets covered by this seal:		
THIS SHEET		

List Corners to be Indexed			
Corners	Section	Twp	Range
South 1/4 Corner	35	T 89 N	R 14 W