

# UNITED STATES PUBLIC LAND SURVEY CORNER CERTIFICATE OF


Land Survey Monuments situated in Section No. 36 Township No. 89 North Range  
No. 14 West of the Fifth Principal Meridian, Black Hawk County, Iowa.  
Previously recorded in \_\_\_\_\_ in County Recorder's Office.

(book, page, document number, etc.)  
(Show reasons for preparing this certificate, the evidence and detailed procedures used in establishing the corner positions and monumentation found or placed.)

Monument Description and Remarks: Found an "x" cut in P.C.C. pavement  
after reconstruction of South Main Street Road as Iowa Highway  
No. 58 relocation.

## PLAN - VIEW

(Show a minimum of three reference ties to durable physical objects, relevant monuments and physical conditions that will enable recovery of the corner.)

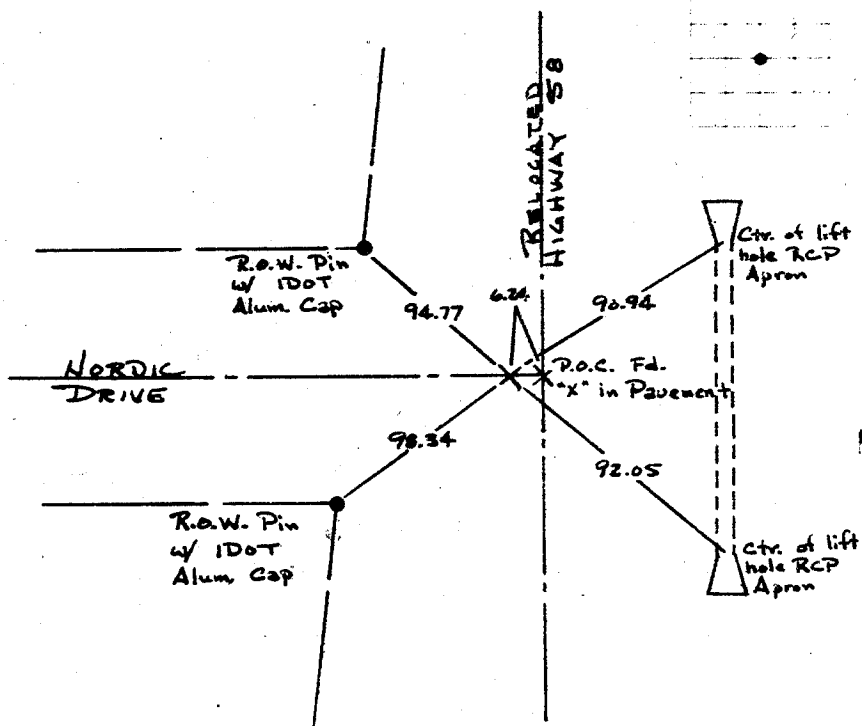


I hereby certify that this land surveying document was prepared by me or under my direct personal supervision and that I am a duly registered Land Surveyor under the laws of the State of Iowa.

R. Allen Dietz  
R. Allen Dietz, L.S.

Iowa Registration No. 12086

October 11, 1993  
Date

SEAL

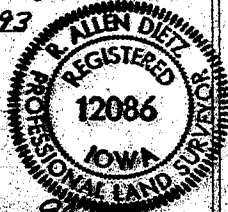

My Registration Expires December 31, 1994

Corners	List Section	Twp	Range
Ctr	36	89	14