

Michael R. Fagle, P.L.S.

AECOM, 501 Sycamore St., Suite 222, Waterloo, Iowa 50703

I-319-232-6531

UNITED STATES PUBLIC LAND SURVEY CORNER CERTIFICATE
OF



Land Survey Monuments situated in Section 36, Township 89 North, Range 14 West, of the Fifth Principal Meridian, Black Hawk County, Iowa. Previously recorded in Fee Book 2004 22645 in County Recorder's Office. (Book, Page, Document Number, etc.)

(Show reason for preparing this certificate, the evidence and detailed procedures used in establishing the corner positions and monumentation found or placed.)

Monument Description and Remarks: Found 1/2" rebar West of the South Bound Lane of Hwy 58 from the previous ties. The corner was destroyed during the construction of Ia. Hwy. 58/Viking Road Interchange Project (IDOT Project No. HSIPX-058-1(92)--3L-07). After the construction was complete an "X" was cut at the previous location and re-tied.

PLAN - VIEW

(Show a minimum of three reference ties to durable physical objects, relevant monuments and physical conditions that will enable recovery of the corner.)

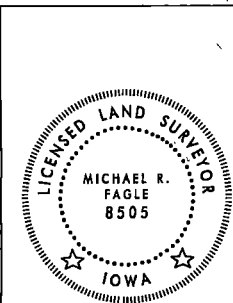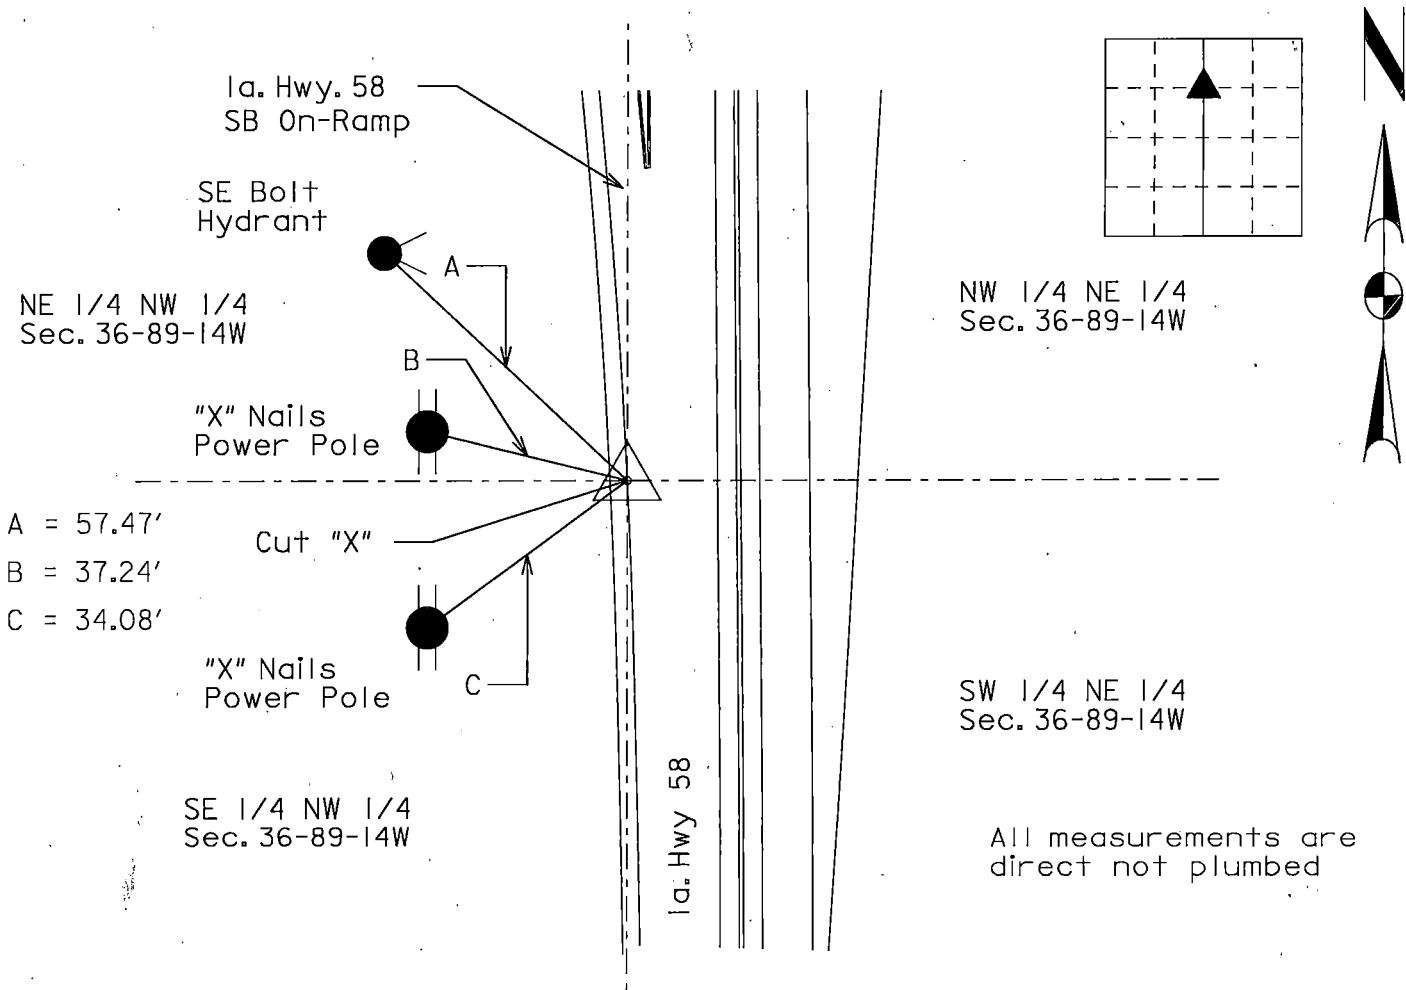

I hereby certify that this Land Surveying document was prepared by me or under my direct personal supervision and that I am a duly Licensed Land Surveyor under the laws of the State of Iowa.

Michael R. Fagle 1-13-2021
MICHAEL R. FAGLE Date
License number 8505
My license renewal date is December 31, 2022
Pages or sheets covered by this seal:
THIS SHEET

List Corners to be Indexed			
Corners	Section	Twp	Range
Northwest Corner of the Southwest 1/4 of the Northeast 1/4	36	T 89 N	R 14 W