

UNITED STATES PUBLIC LAND SURVEY CORNER CERTIFICATE OF


Land Survey Monuments situated in Section No. 36 Township No. 89 North, Range
No. 14 West, of the Fifth Principal Meridian, Black Hawk County, Iowa.
Previously recorded in _____ in County Recorder's Office

(book, page, document number, etc.)
(Show reason for preparing this certificate, the evidence and detailed procedures used in establishing the corner positions and monumentation found or placed.)

Monument Description and Remarks: Found an "x" cut in P.C.C. pavement
after reconstruction of South Main Street Road as Relocated
Iowa Highway No. 58.

PLAN - VIEW

(Show a minimum of three reference ties to durable physical objects, relevant monuments and physical conditions that will enable recovery of the corner.)

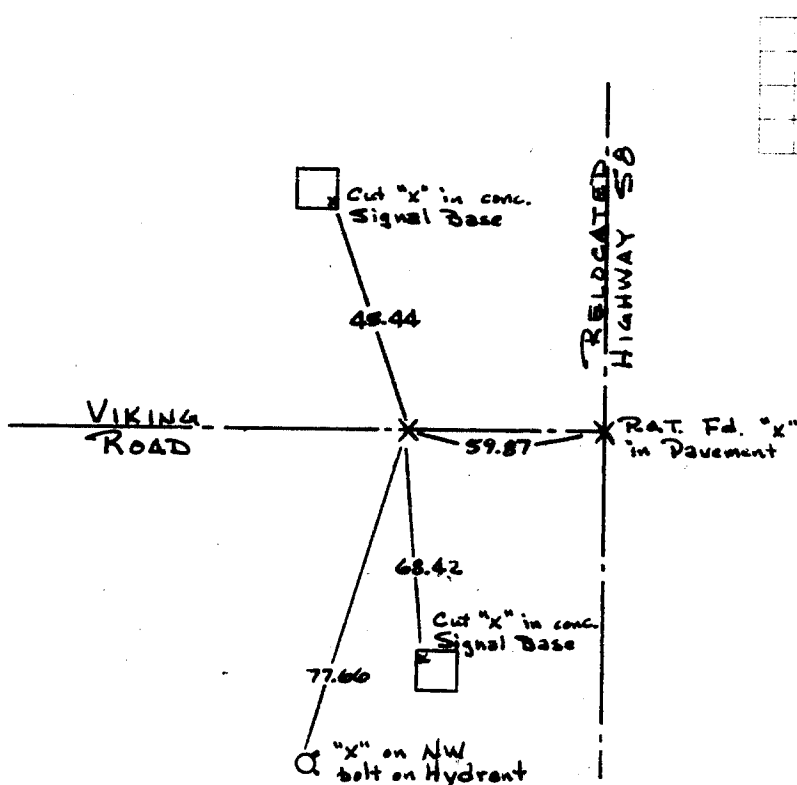

I hereby certify that this land surveying document was prepared by me or under my direct personal supervision and that I am a duly registered Land Surveyor under the laws of the State of Iowa.

R. Allen Dietz
R. Allen Dietz, L.S.

October 11, 1994
Date

SEAL



My Registration Expires December 31, 1994

Corners	List Corners to be Indexed	Section	Twp	Range
N 1/4	36	89	14	

358-557

