


UNITED STATES PUBLIC LAND SURVEY CORNER CERTIFICATE
OF

Land Survey Monuments situated in Section 36, Township 89 North, Range 14 West, of the Fifth Principal Meridian, Black Hawk County, Iowa.
Previously recorded in Book _____, Page _____.

(Show reason for preparing this certificate, the evidence and detailed procedures used in establishing the corner positions and monumentation found or placed.)
Monument Description and Remarks: Found concrete monument with brass cap set by W.P.A. over stone. Records show stone marking corner in 1872.

PLAN - VIEW

(Show a minimum of three reference ties to durable physical objects, relevant monuments and physical conditions that will enable recovery of the corner.)

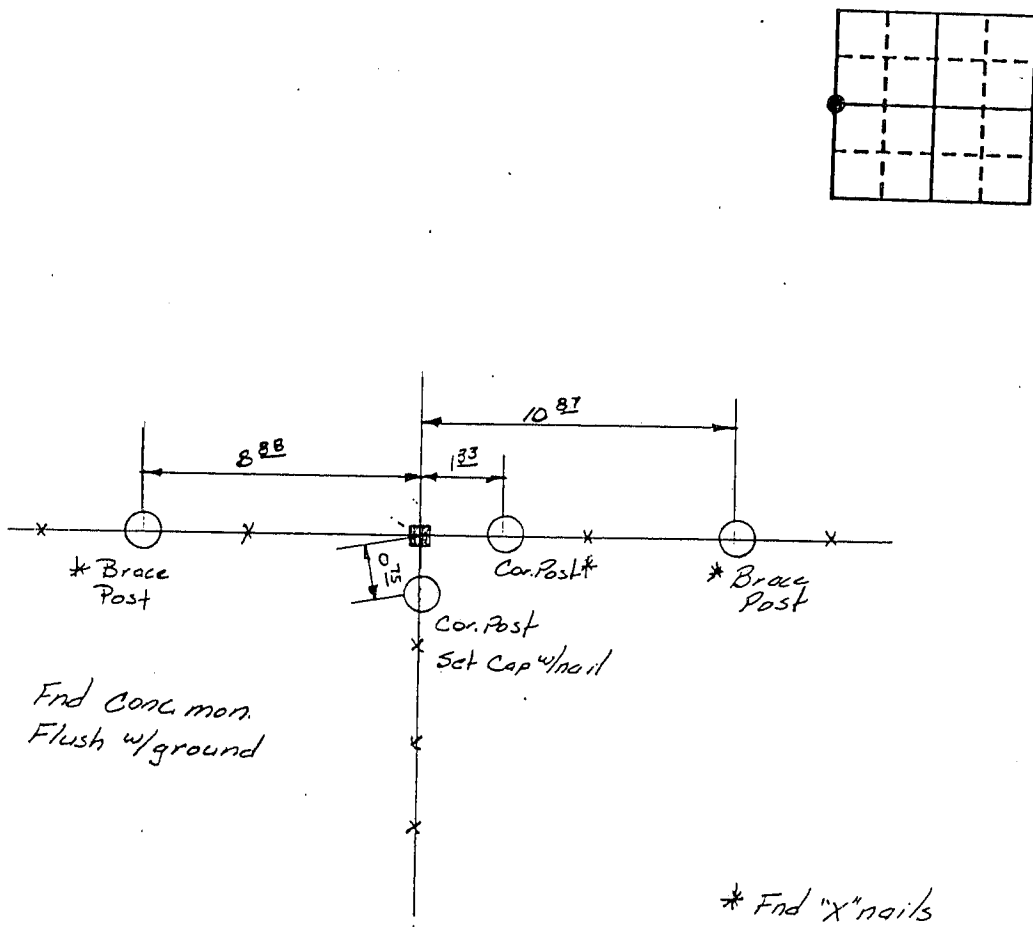

I hereby certify that the survey work was completed and this certificate was prepared by me or under my direct personal supervision and that I am a duly registered land surveyor under the laws of the state of Iowa.

Keith E. Vlademar 11/26/90
REGISTERED LAND SURVEYOR NO. 9781

SEAL



List Corners to be Indexed

Corners	Section	Twp	Range
W 1/4 Cor.	36	89N	14W
E 1/4 Cor	35	89N	14W