



Doc ID: 011953950001 Type: GEN  
Recorded: 06/06/2023 at 01:39:39 PM  
Fee Amt: \$7.00 Page 1 of 1  
Black Hawk County Iowa  
SANDIE L. SMITH RECORDER

File **2023-00016337**

ENV  
X

Prepared By / Return To: Fayette County Engineer, P.O. Box 269, 114 N. Vine St., West Union, Iowa (563)-422-3552


UNITED STATES PUBLIC LAND SURVEY CORNER CERTIFICATE

Land Survey Monuments situated in Section 1, Township 90 North, Range 11 West  
of the Fifth Principal Meridian, Black Hawk County, Iowa.

Previously recorded in 200520424 in County Records's Office.  
(book, page, document number, etc.)

Monument Description and Remarks: NE Corner of Section 1-T90N-R11W:  
Found bar with aluminum cap labeled Black Hawk Co. prior to HMA paving project matching ties recorded in Fayette County as Document No.  
2003-4754. Re-established the corner position by coordinates obtained prior to paving project and set a Mag Spike as the Section Corner.

PLAN VIEW

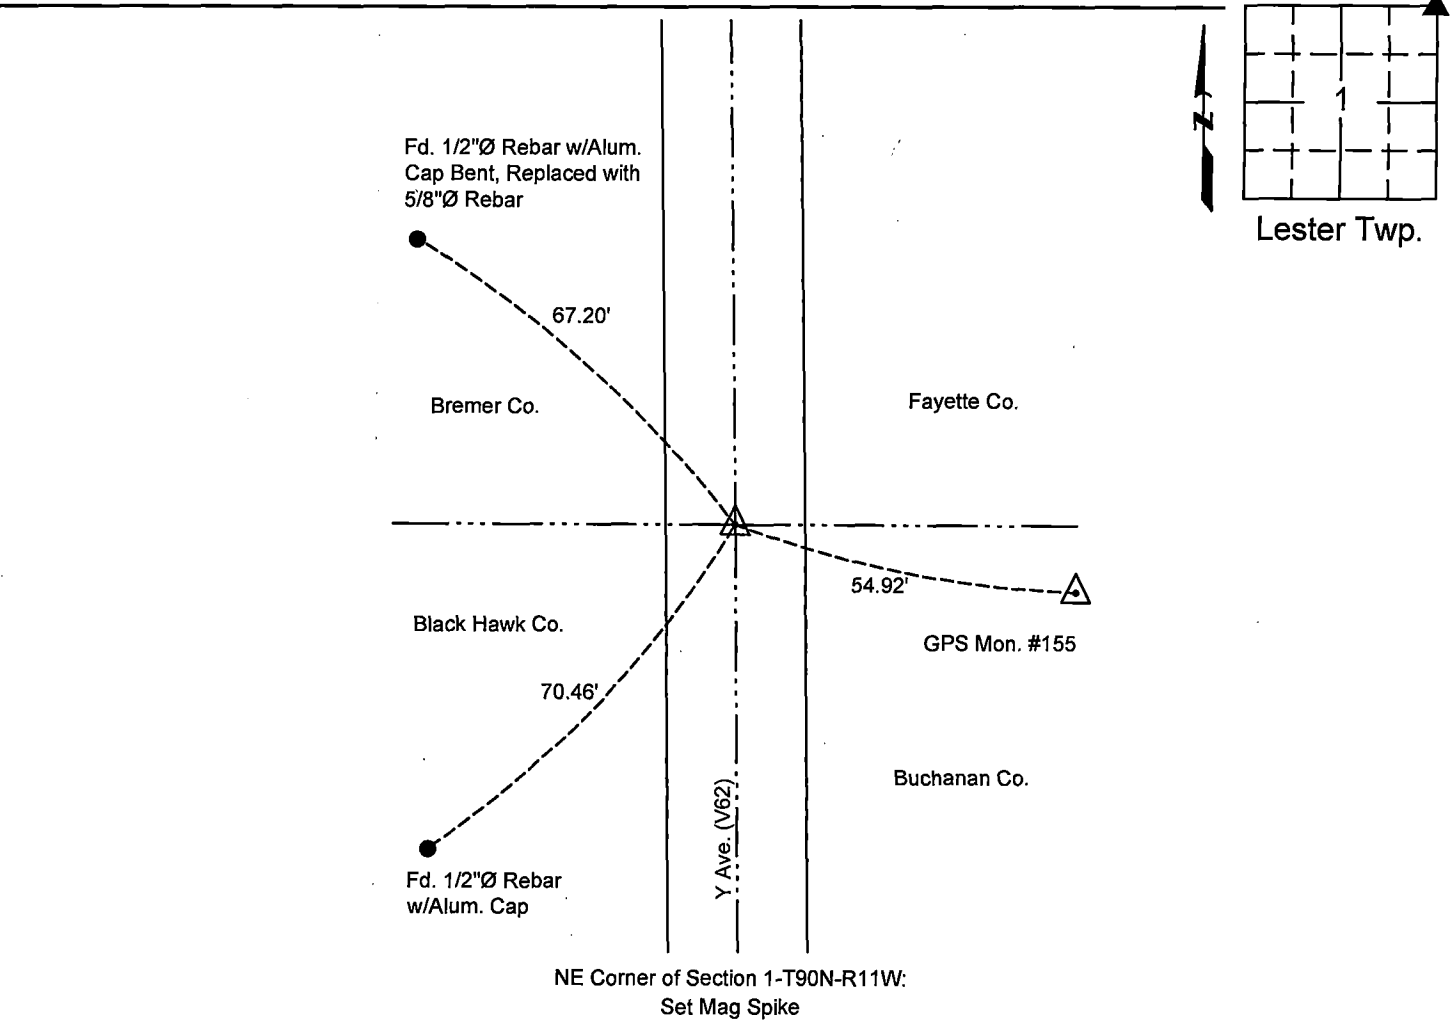

NE Corner of Section 1-T90N-R11W:  
Set Mag Spike

	I hereby certify that this land surveying document was prepared and the related survey work was performed by me or under my direct personal supervision and that I am a duly licensed Land Surveyor under the laws of the State of Iowa.	List Corners to be Indexed		
	<u>Matthew J. McElree</u> Matthew J. McElree, P.L.S. License Number 21640 My license renewal date is December 31, 2024. Sheets covered by this seal: This Sheet Only	<u>6-5-23</u> Date	Corners	Section Twp. Range
		NE	1 90N 11W	

7.00

(7)

1