

INDEX ^{SW}
MARGIN
PROOF
COMPARE*Christine A. Less*

Recorder

FEE 1-5.00/

CES PO BOX 898 WATERLOO IA 50704

SLSI 9-90

UNITED STATES PUBLIC LAND SURVEY CORNER CERTIFICATE

OF

Land Survey Monuments situated in Section 5, Township 90N, Range 11W, of the Fifth Principal Meridian, BLACK HAWK County, Iowa.
Previously recorded in N/A in County Recorder's Office.


(book, page, document number, etc.)

(Show reason for preparing this certificate, the evidence and detailed procedures used in establishing the corner positions and monumentation found or placed.)

Monument Description and Remarks: N¹/₄ CORNER: FOUND 5/8" Ø REBAR FLUSH W/ TOP A/CPAINT IN CENTER PAINTED X.

PLAN - VIEW

(Show a minimum of three reference ties to durable physical objects, relevant monuments and physical conditions that will enable recovery of the corner.)

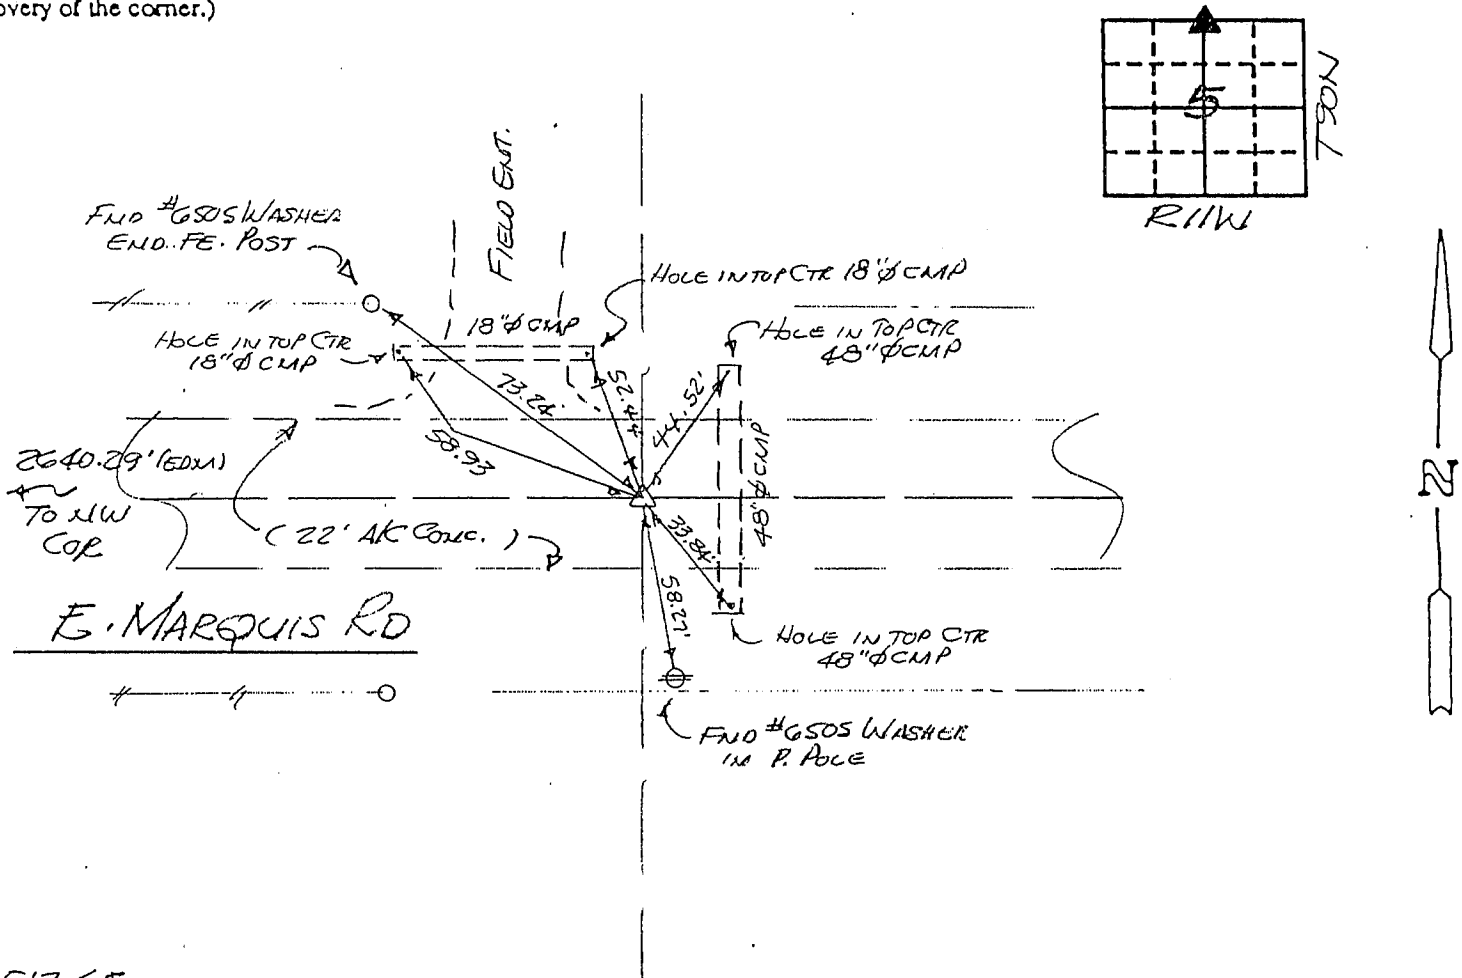

517-65

I hereby certify that the survey work was completed and this certificate was prepared by me or under my direct personal supervision and that I am a duly registered land surveyor under the laws of the state of Iowa.

Signature: *F. William King*Name typed or printed: F. WILLIAM KINGDate: 1-21-2002Reg. No. 6033

Corners

N¹/₄

List Corners to be Indexed

Section

5

Twp

90N

Range

11W

SEAL

