

INDEX &
MARGIN
PROOF
COMPARE

BLACK HAWK COUNTY IOWA:SS 019844
Filed for record JAN 22, 2002 at
4:00 P. M. and recorded in Book
of _____ page _____

Christine A. Less

Recorder

FEE 1-5.00/
CES PO BOX 898 WATERLOO IA 50704

SLSI 9-90

UNITED STATES PUBLIC LAND SURVEY CORNER CERTIFICATE

OF

Land Survey Monuments situated in Section 5, Township 90 N, Range
11 W, of the Fifth Principal Meridian, BLACK HAWK County, Iowa.
Previously recorded in N/A in County Recorder's Office.

(book, page, document number, etc.)


Show reason for preparing this certificate, the evidence and detailed procedures used in establishing the corner positions and monumentation found or placed.)

Monument Description and Remarks: 11W CORNER: FOUND 5/8" Ø DEBAG FLUSH IN A/C

PAV'T w/ PAINTED X.

PLAN - VIEW

(Show a minimum of three reference ties to durable physical objects, relevant monuments and physical conditions that will enable recovery of the corner.)

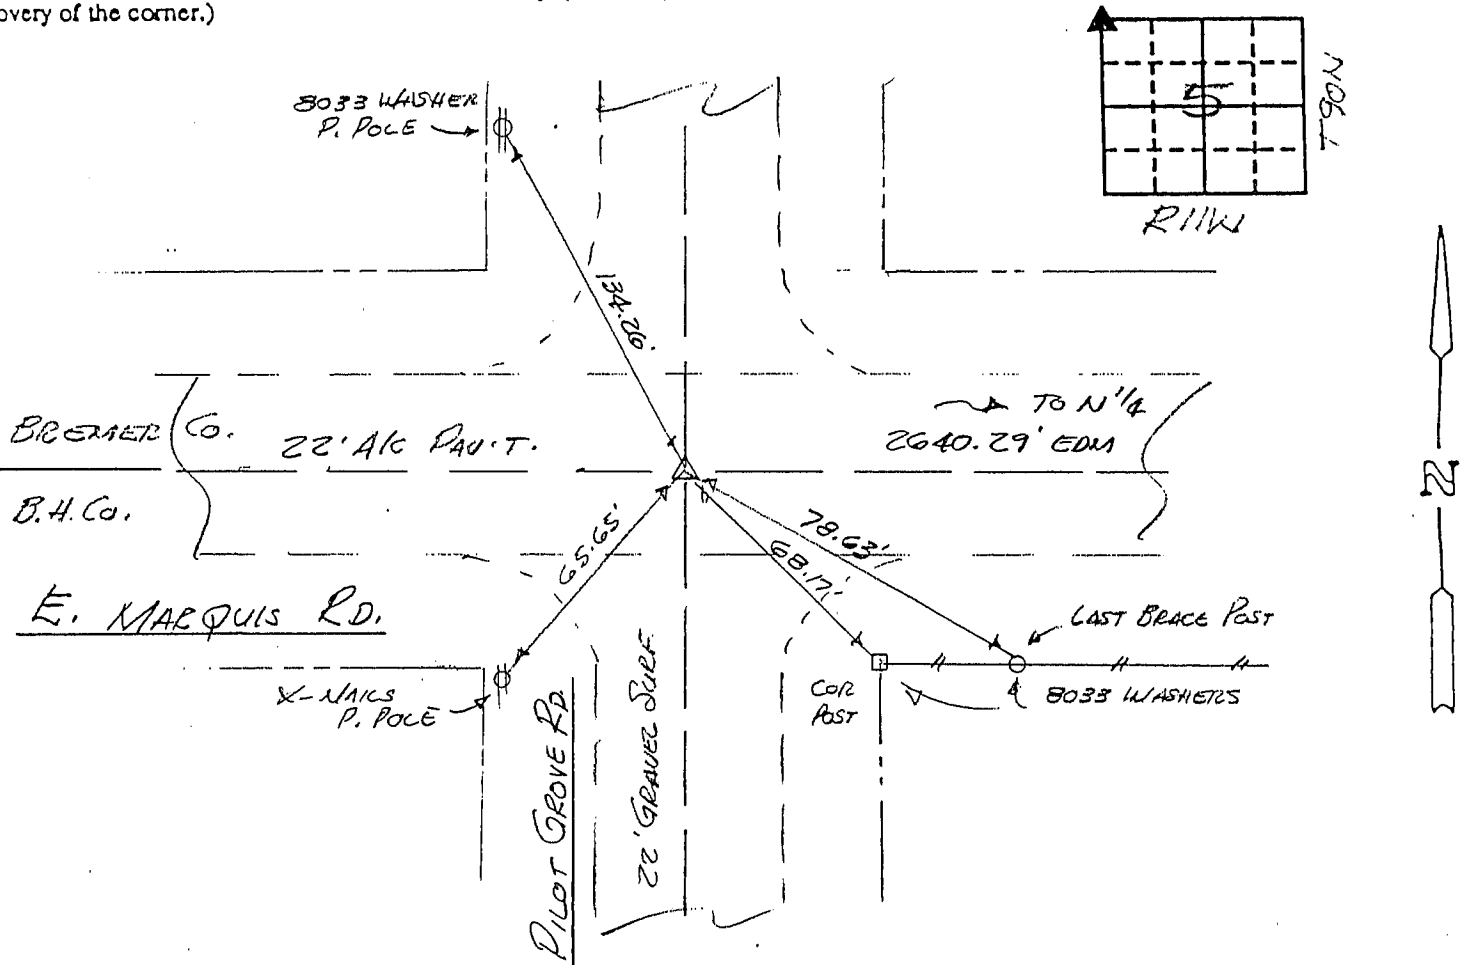

517-65

I hereby certify that the survey work was completed and this certificate was prepared by me or under my direct personal supervision and that I am a duly registered land surveyor under the laws of the state of Iowa.

Signature: *F. William King*

Name typed or printed: F. WILLIAM KING

Date: Jan. 21, 2002 Reg. No. 8033

Corners	List Corners to be Indexed	Section	Twp	Range
11W	5	90N	11W	

SEAL

