


SLS19-90

LAND SURVEY CORNER CERTIFICATE

Section 5 Township 90 North Range 11
County, Iowa
in County Recorder's Office.
Black Hawk
See below

PLAN - VIEW

(Show a minimum of three reference ties to durable physical objects, relevant monuments and physical conditions that will enable recovery of the corner.)

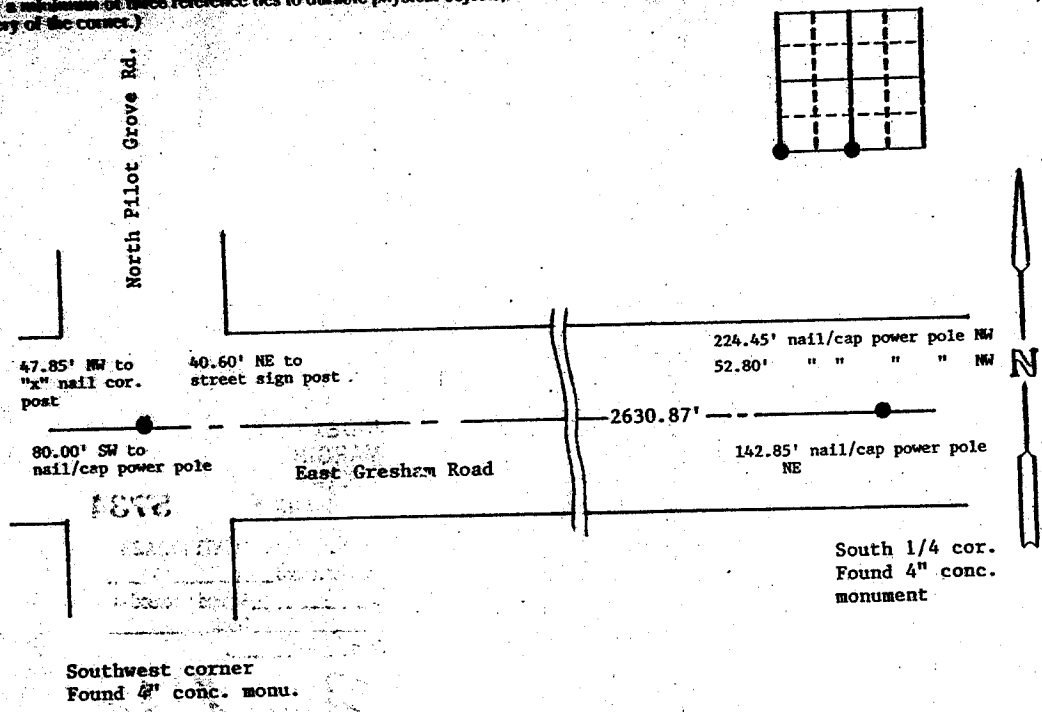

I hereby certify that the survey work was completed and this certificate was prepared by me or under my direct personal supervision and that I am a duly registered land surveyor under the laws of the state of Iowa.

Signature: Steve Busse
Name typed or printed: STEVE BUSSE
Date: 9/24/94 Reg. No. 9018

REGISTRATION IS SUBJECT TO RENEWAL DEC. 31, 199

Corners	List Corners to be Indexed		
	Section	Twp	Range
SW cor.	5	90	11
South 1/4 cor.	5	90	11

