2024-18917

RECORDED: 08/16/2024 12:19:05 PM

RECORDING FEE: \$7.00 IOWA E-FILING FEE: \$3.00 COMBINED FEE: \$10.00 REVENUE TAX: \$0.00

SANDIE L. SMITH, RECORDER BLACK HAWK COUNTY, IOWA

Prepared by & Return to: Isaiah M. Reicks, HRS, LLC, 2206 East Bremer Avenue, Waverly, IA 50677, Phone 319-483-5187

## **United States Public Land Survey Corner Certificate**

Land Survey Monument situated in

Section **6**, Township **90** North, Range **11** West of the Fifth Principal Meridian, **Black Hawk** County, Iowa. Not On file in the County Recorder's Office.

This certificate is being prepared in compliance with Iowa Code Chapter 355.11 because:

There is no certificate on file for this corner.
There are no longer three valid ties of record.
There are changes to reference ties of record.

There are changes to reference ties of record.

There is change of monumentation of record.

To clarify description of record monument (ties).


## **Monument Description and Remarks:**

## East 1/4 Corner:

Found Broken Standard Concrete Monument (top broke off) with information obtained from the County Engineer's Office. Placed Cut "X" at the Center of said found monument to perpetuate this corner. Set 5/8"Ø rebar 0.30' (South) as a magnetic accessory to aid in the future recovery of said monument. Set 3 new ties to aid in the future recovery of Corner.

## **Plan View - Not to Scale**

(Show a minimum of three reference ties to durable physical objects, relevant monuments and physical conditions that will enable recovery of the corner.)

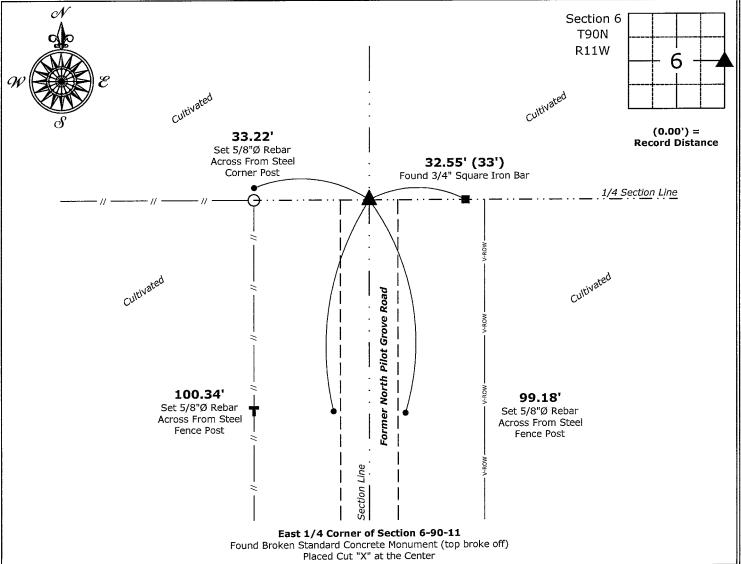

ISAIAH M.
REICKS TO WALL OF WA

I hereby certify that this land surveying document was prepared and the related survey work was performed by me or under my direct personal supervision and that I am a duly licensed Land Surveyor under the laws of the State of Iowa.

Isajah M. Reicks

8-14-24 Date:

License number 22468
My license renewal date is December 31, 2025.
Sheets covered by this seal: Individual sheet only

List Corner to be Indexed

Corner Section Township Range

E 1/4 6 90 11

Project Number: 2024-570 FB: Black Hawk 12, Page(s) 18-19 File: I:\\_\_Projects - WO\County Control Systems\\_WO\BLACK HAWK\BHCO-5\BHCO-5-2024.dwg, 8/16/2024 10:17:17 AM