2024-18916

RECORDED: 08/16/2024 12:19:04 PM

**RECORDING FEE: \$7.00 IOWA E-FILING FEE: \$3.00 COMBINED FEE: \$10.00 REVENUE TAX: \$0.00** 

SANDIE L. SMITH, RECORDER **BLACK HAWK COUNTY, IOWA** 

Prepared by & Return to: Isaiah M. Reicks, HRS, LLC, 2206 East Bremer Avenue, Waverly, IA 50677, Phone 319-403-5187

## United States Public Land Survey Corner Certificate

Land Survey Monument situated in

Section 6, Township 90 North, Range 11 West of the Fifth Principal Meridian, Black Hawk County, Iowa. On file in Book 312, Page 803 in the County Recorder's Office.

This certificate is being prepared in compliance with Iowa Code Chapter 355.11 because:


There is no certificate on file for this corner. There are no longer three valid ties of record. There are changes to reference ties of record. There is change of monumentation of record. To clarify description of record monument (ties).

## **Monument Description and Remarks:**

## **Southeast Corner:**

Found Standard Concrete Monument with information obtained from previously recorded Section Corner Certificate. Set 4 new ties to aid in the future recovery of Corner.

## **Plan View - Not to Scale**

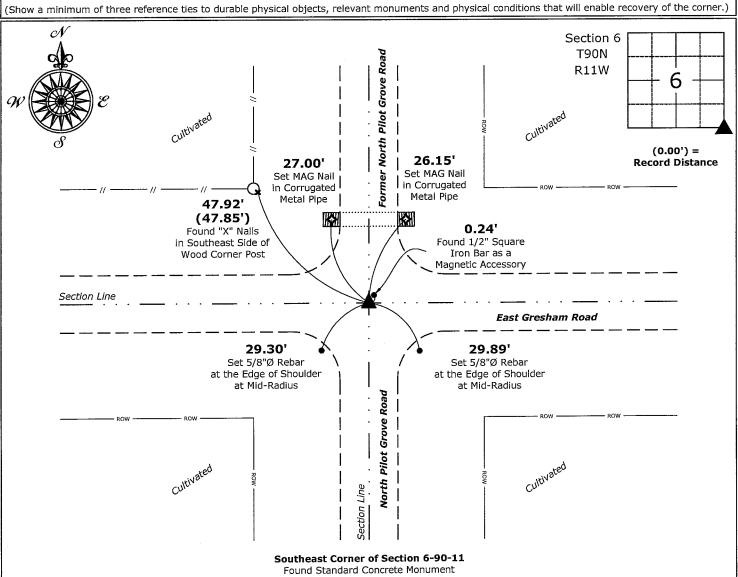



I hereby certify that this land surveying document was prepared and the related survey work was performed by me or under my direct personal supervision and that I am a duly licensed Land Surveyor under the laws of the State of Iowa.

-16-24 Date:

License number 22468

My license renewal date is December 31, 2025. Sheets covered by this seal: Individual sheet only

List Corner to be Indexed			
Corner	Section	Township	Range
SE	6	90	11

Project Number: 2024-570 FB: Black Hawk 12, Page(s) 18-19 Projects - WO\County Control Systems \\_WO\BLACK HAWK\BHCO-5\BHCO-5-2024.dwg, 8/16/2024 10:17:04 AM E E