2024-18920

RECORDED: 08/16/2024 12:19:08 PM

RECORDING FEE: \$7.00 IOWA E-FILING FEE: \$3.00 COMBINED FEE: \$10.00 REVENUE TAX: \$0.00

SANDIE L. SMITH, RECORDER BLACK HAWK COUNTY, IOWA

Prepared by & Return to: Isaiah M. Reicks, HRS, LLC, 2206 East Bremer Avenue, Waverly, IA 50677, Phone 319-403-5187

## **United States Public Land Survey Corner Certificate**

Land Survey Monument situated in

Section **6**, Township **90** North, Range **11** West of the Fifth Principal Meridian, **Black Hawk** County, Iowa. On file in **Book 304**, **Page 208** in the County Recorder's Office.

This certificate is being prepared in compliance with Iowa Code Chapter 355.11 because:

□ There is no certificate on file for this corner.
 □ There are no longer three valid ties of record.
 □ There are changes to reference ties of record.
 □ There is change of monumentation of record.
 □ To clarify description of record monument (ties).


## **Monument Description and Remarks:**

## West 1/4 Corner:

Found 1/2"Ø Rebar w/Orange Plastic Cap PLS 7060 with information obtained from the previously recorded Section Corner Certificate. See Plat of Survey, as recorded in Document Number 2024-18280, on file in the County Recorder's Office, for more information.

## Plan View - Not to Scale

(Show a minimum of three reference ties to durable physical objects, relevant monuments and physical conditions that will enable recovery of the corner.)

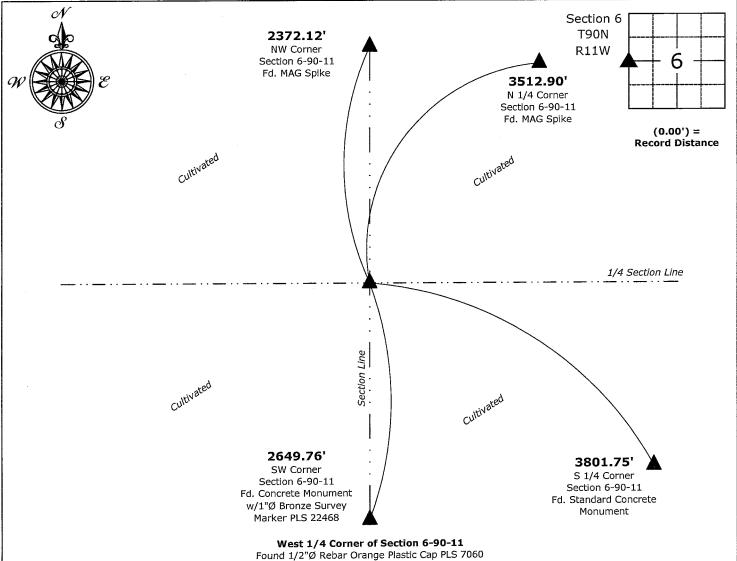

ISAIAH M. REICKS TO 22468

I hereby certify that this land surveying document was prepared and the related survey work was performed by me or under my direct personal supervision and that I am a duly licensed Land Surveyor under the laws of the State of Iowa.

Surveyor under the laws of the State of Iowa.

Isaiah M. Reicks

Date:

License number 22468

My license renewal date is December 31, 2025. Sheets covered by this seal: Individual sheet only

List Corner to be Indexed			
Corner	Section	Township	Range
W 1/4	6	90	11

Project Number: 2024-570 FB: Black Hawk 12, Page(s) 18-19 File: I:\\_\_Projects - WO\County Control Systems\\_WO\BLACK HAWK\BHCO-5\BHCO-5-2024.dwg, 8/16/2024 10:18:12 AM