


I  
P  
Z

Document Number: 2007024449  
 Date: May 18, 2007 4:30:00 pm  
 Aud Fee: 0.00 Rec Fee: \$5.00  
 Trans Tax: 0.00 Rec Management Fee: 1.00  
 E-Com Fee: 1.00 Non-Standard Page Fee: 0.00  
 Filed for record in Black Hawk County, Iowa  
 Judith A. McCarthy, County Recorder


Kirk D. Eschliman, P.L.S. Iowa Lic. No. 9961, 723 Broadway Street, Waterloo, Iowa 50703 - Phone: 319-234-0509

**UNITED STATES PUBLIC LAND SURVEY CORNER CERTIFICATE OF**  
 LAND SURVEY MONUMENTS SITUATED IN SECTION 8, TOWNSHIP 90 NORTH, RANGE 11 WEST, OF THE FIFTH PRINCIPAL  
 MERIDIAN, BLACK HAWK COUNTY, IOWA. NOT PREVIOUSLY RECORDED.  
 (SHOW REASON FOR PREPARING THIS CERTIFICATE, THE EVIDENCE AND DETAILED PROCEDURES USED IN ESTABLISHING THE CORNER POSITIONS AND  
 MONUMENTATION FOUND OR PLACED.)  
 MONUMENT DESCRIPTION AND REMARKS: NO CURRENT SECTION CORNER CERTIFICATE ON FILE IN THE BLACK HAWK  
 COUNTY RECORDER'S OFFICE. SET SURVEY MARKER NAIL IN A.C.C. PAVEMENT ROADWAY. MONUMENT USED FOR  
 SURVEY IN NW 1/4 OF SECTION 9.

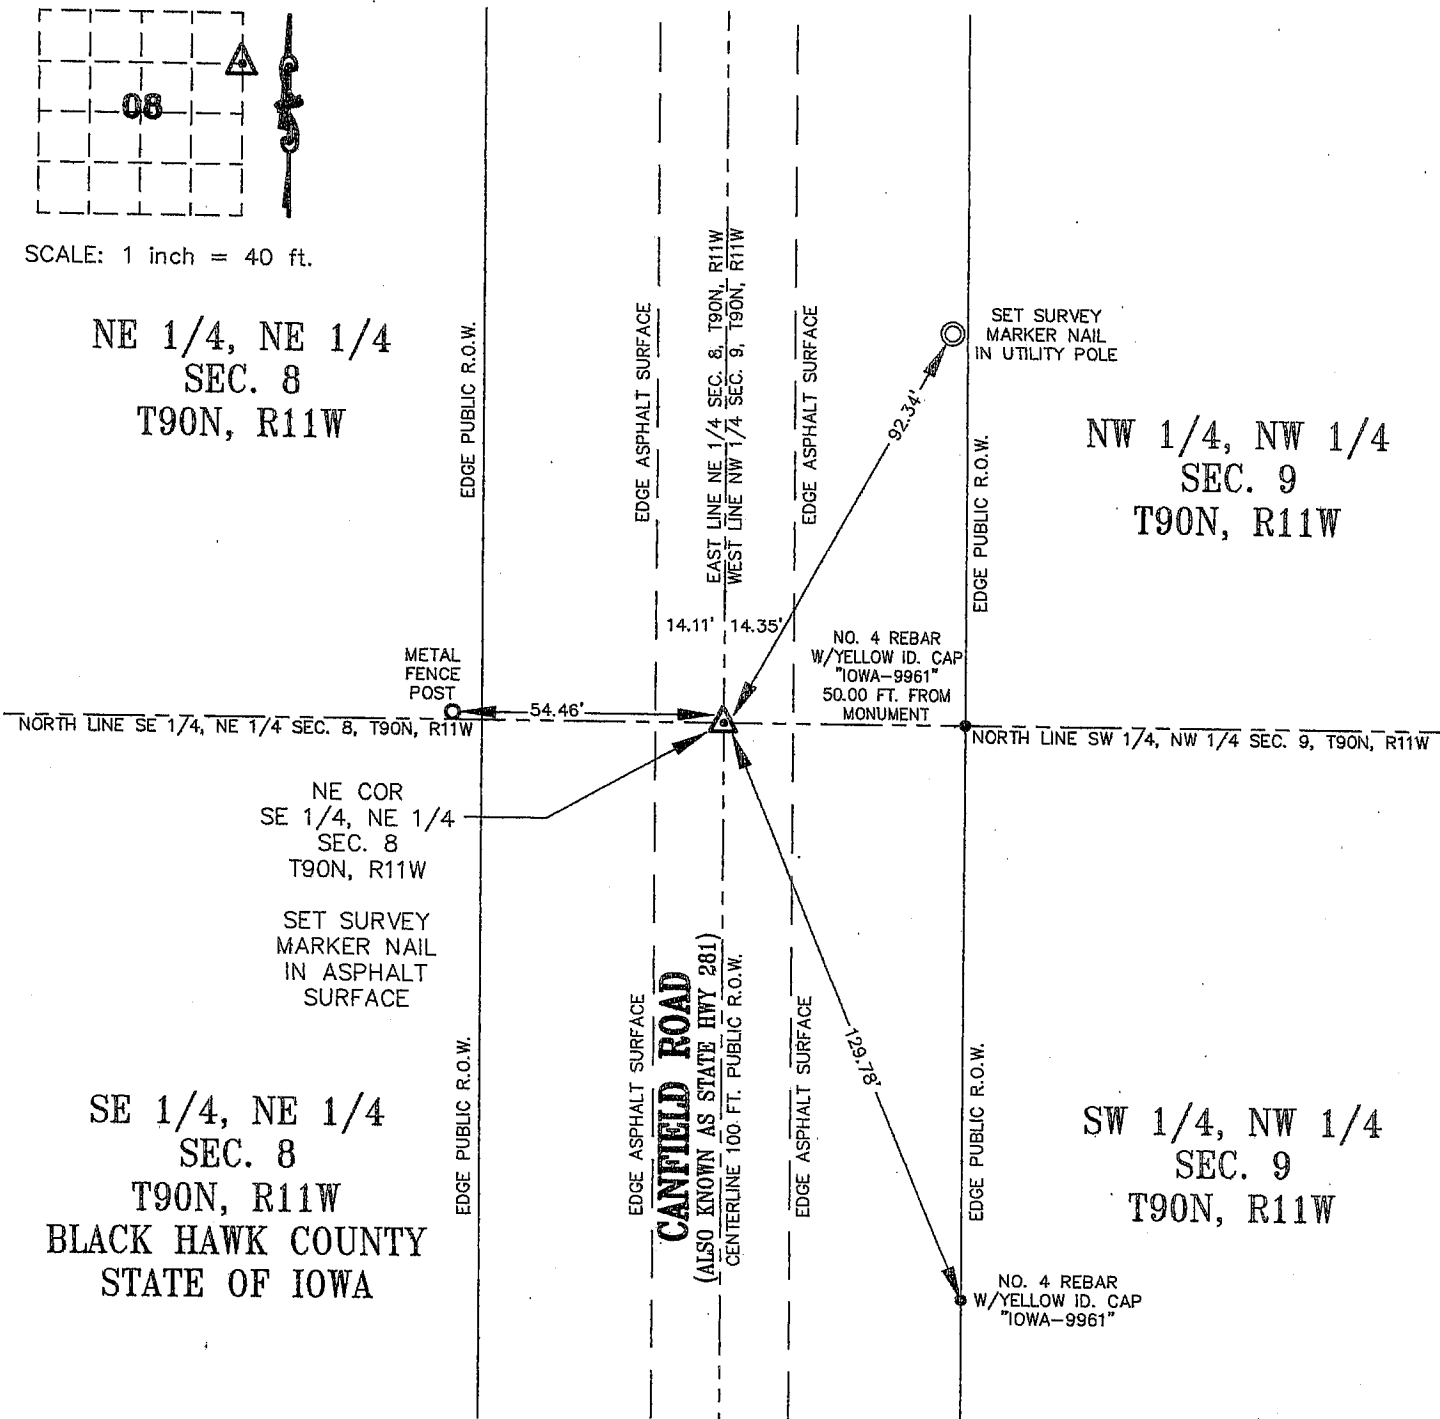

I HEREBY CERTIFY THAT THIS LAND SURVEYING DOCUMENT  
 WAS PREPARED AND THE RELATED SURVEY WORK WAS  
 PERFORMED BY ME OR UNDER MY DIRECT PERSONAL  
 SUPERVISION AND THAT I AM A DULY LICENSED LAND  
 SURVEYOR UNDER THE LAWS OF THE STATE OF IOWA.

*Kirk D. Eschliman* DATE: 05/01/2007  
 KIRK D. ESCHLIMAN, P.L.S. IOWA LIC. NO. 9961  
 MY LICENSE RENEWAL DATE IS DECEMBER 31, 2007  
 PAGES OR SHEETS COVERED BY THIS SIGNATURE & SEAL: SHEET 1 OF 1

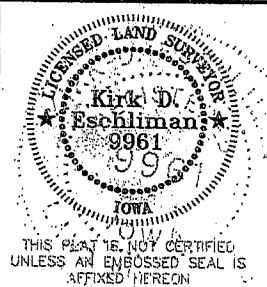

LIST OF CORNERS TO BE INDEXED:			
CORNER	SEC	TWP	RANGE
NE COR.	8	90	11
SE 1/4, NE 1/4			

**KESS & ASSOCIATES, INC.**  
 723 BROADWAY, WATERLOO, IOWA 50703-5811 PHONE: (319) 234-0509

DATE OF FIELD WORK: APRIL 30, 2007  
 DWG. DATE: 05/01/2007 DRAWN BY: BJYK  
 CADD FILE: 07A50SCC1.DWG PROJECT NO.: 07A50