

SC
MISC
INDEX
MARGIN
PROOF
COMPARE

BLACK HAWK COUNTY IOWA:SS 027185
Filed for record APR 8, 2002 at
4:00 P.M. and recorded in Book 346
of MISC Page 228

Patricia A. Lee RECORDER
FEE 1-5.00/
ENV ANDERSON-BOGERT ENGINEERS & SURVEYORS INC
229 NORTHLAND CT NE
CEDAR RAPIDS IA 52402

SLSI 9-90

229 Northland Court N.E. Cedar Rapids, Iowa 52402 Phone: (319) 377-4629

UNITED STATES PUBLIC LAND SURVEY CORNER CERTIFICATE
OF


Land Survey Monuments situated in Section 9, Township 90 North, Range 11 West, of the Fifth Principal Meridian, Black Hawk County, Iowa.
Previously recorded in N/A in County Recorders Office.
(book, page, document number, ect.)

(Show reason for preparing this certificate, the evidence and detailed procedures used in establishing the corner positions and monumentation found or placed.)


Monument Description and Remarks: Found 1/2" Iron Rod at the S 1/4 Corner of Section 9-90-11. Found 1/2" Iron Rod at the SE Corner of Section 9-90-11.

PLAN - VIEW


(Show a minimum of three reference ties to durable physical objects, relevant monuments and physical conditions that will enable recovery of the corner.)

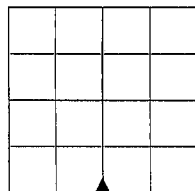


SECTION 9

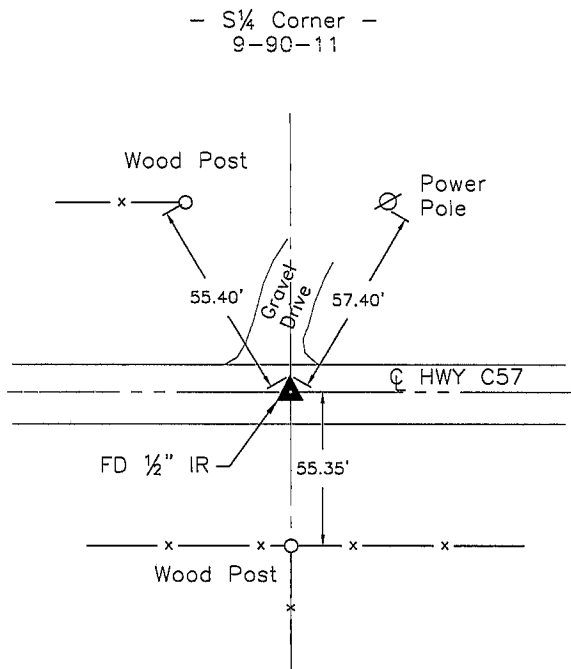

Set Nails with Survey Disk.

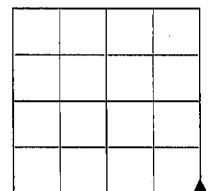

SECTION 9

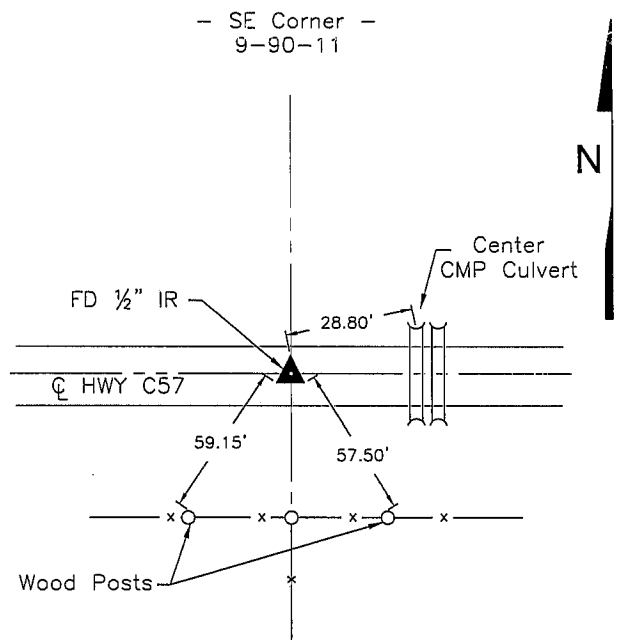

Set Nails with Survey Disks.


I hereby certify that the survey work was completed and this certificate was prepared by me or under my direct personal supervision and that I am a duly licensed land surveyor under the laws of the state of Iowa.



Date: 3/27/2002 No. 11809

SEAL

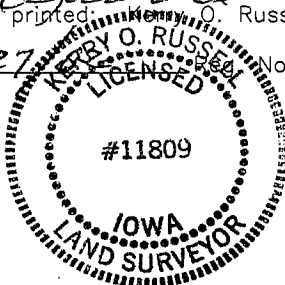

| Corners | List Corners to be Indexed | | |
|------------|----------------------------|-----|-------|
| | Section | Twp | Range |
| S 1/4 Cor. | 9 | 90N | 11W |
| SE Cor. | 9 | 90N | 11W |