

ENTERED
5-3-92
JAD

SLSI 9-90

UNITED STATES PUBLIC LAND SURVEY CORNER CERTIFICATE

OF


Land Survey Monuments situated in Section 11, Township 90 N, Range 11 W, of the Fifth Principal Meridian, BLACK HAWK County, Iowa. previously recorded in N/A in County Recorder's Office.
(book, page, document number, etc.)

(Show reason for preparing this certificate, the evidence and detailed procedures used in establishing the corner positions and monumentation found or placed.)

Monument Description and Remarks: SET 1/2" REBAR #8033 CAP AT PROPRATE DIST. JOHN BALL 1871 SURVEY (SE 1/4 = 40.00 CH, NE 1/4 = 40.26 CH), ON SPLIT OF ROADWAY. WPA NOTES OF 1939 SHOW N-S DIST NE TO SE OF 5322', 1994 DIST = 5279.70'. DUG HOLES @ (OPR. DIST, SPLIT OF 1994 DIST, ALSO AT 1322 SO. OF NO 18 LN FENCE & AT PROPRATE BALL SURVEY DIST, FOUND NOTHING. WPA NOTES SEEM TO BE IN ERROR N-S (NOTE N.E. EKW (NAPS) ROAD SHOWN AT 80' WIDE).

PLAN - VIEW

(Show a minimum of three reference ties to durable physical objects, relevant monuments and physical conditions that will enable recovery of the corner.)

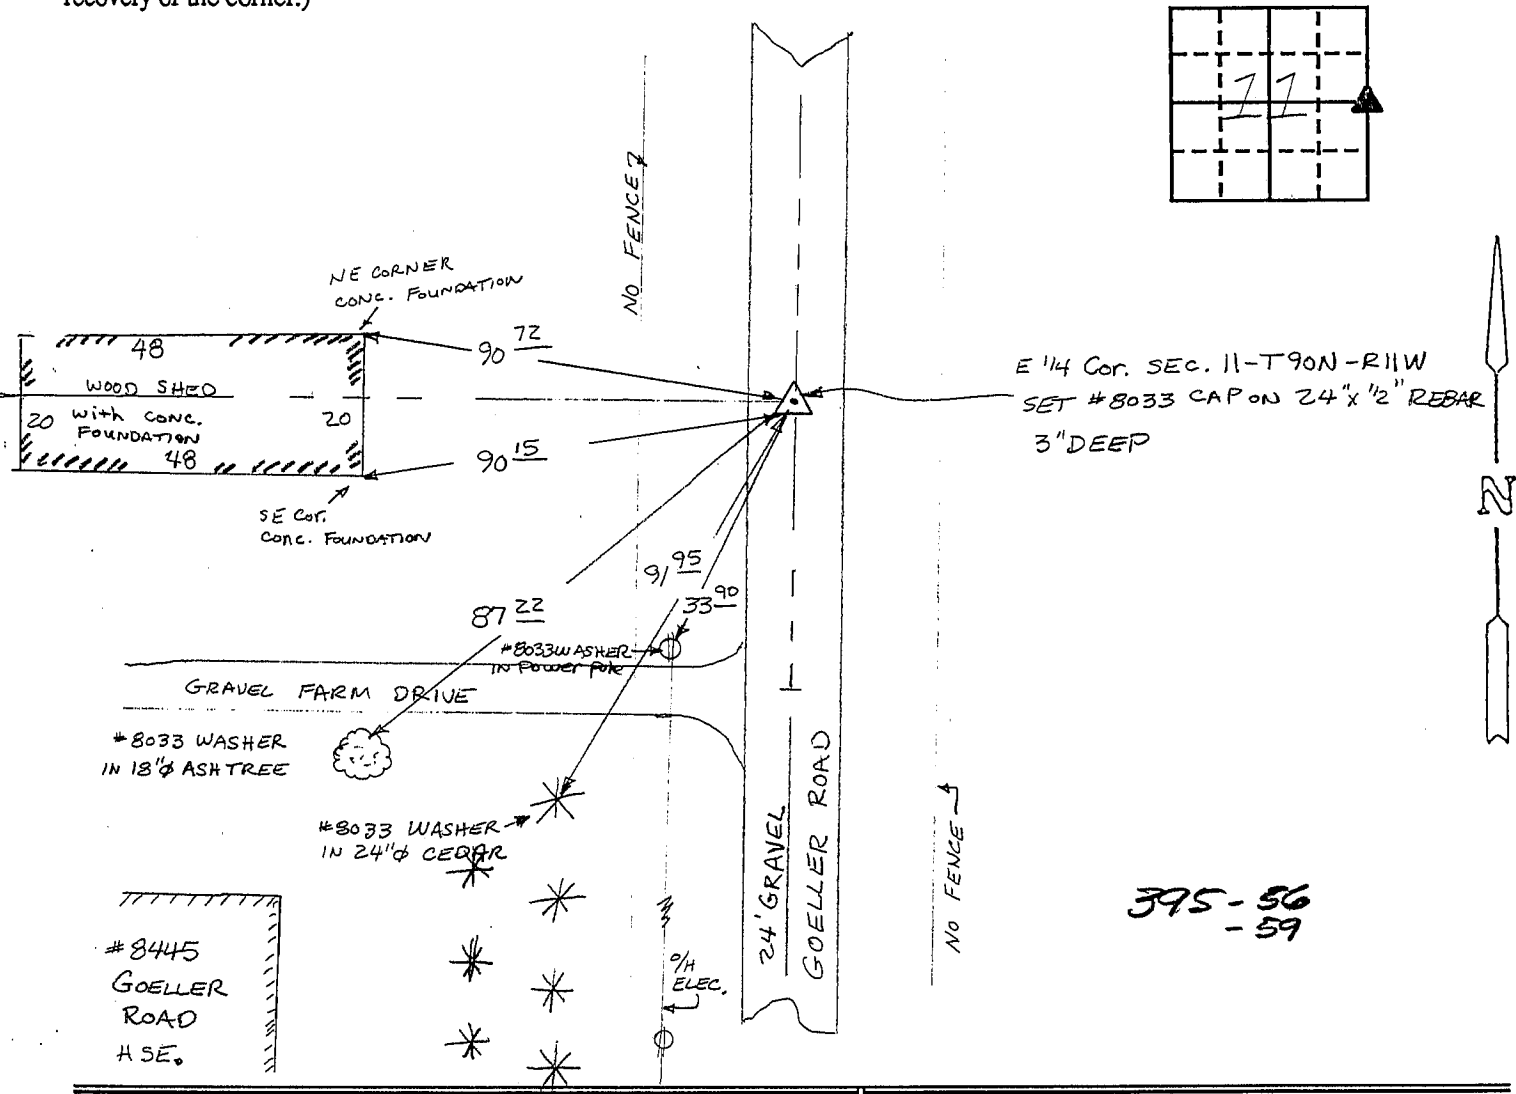

I hereby certify that the survey work was completed and this certificate was prepared by me or under my direct personal supervision and that I am a duly registered land surveyor under the laws of the state of Iowa.

Signature: F. William King
Name typed or printed:

Date: 1-25-1994 Reg. No. 8033

SEAL

Corners	List Corners to be Indexed		
	Section	Twp	Range
E 1/4	11	90N	11W

WAYNE CLAASSEN ENGINEERING
AND SURVEYING, INC.
2709 UNIVERSITY AVE.
P.O. BOX 898
WATERLOO, IA 50704