

ENTERED
5-2-94
BKS E
SLSI 9-90

UNITED STATES PUBLIC LAND SURVEY CORNER CERTIFICATE

OF


Land Survey Monuments situated in Section 11, Township 90N, Range R11W, of the Fifth Principal Meridian, BLACK HAWK County, Iowa. Previously recorded in N/A in County Recorder's Office.

(book, page, document number, etc.)
(Show reason for preparing this certificate, the evidence and detailed procedures used in establishing the corner positions and monumentation found or placed.)

Monument Description and Remarks: FOUND SIGN FLUSH WITH SURFACE OF ROADWAY.
TOP BROKEN OFF BY COUNTY MAINTAINERS. SET 1/2" REBAR ON NO. EDGE OF
MONUMENT.

PLAN - VIEW

(Show a minimum of three reference ties to durable physical objects, relevant monuments and physical conditions that will enable recovery of the corner.)

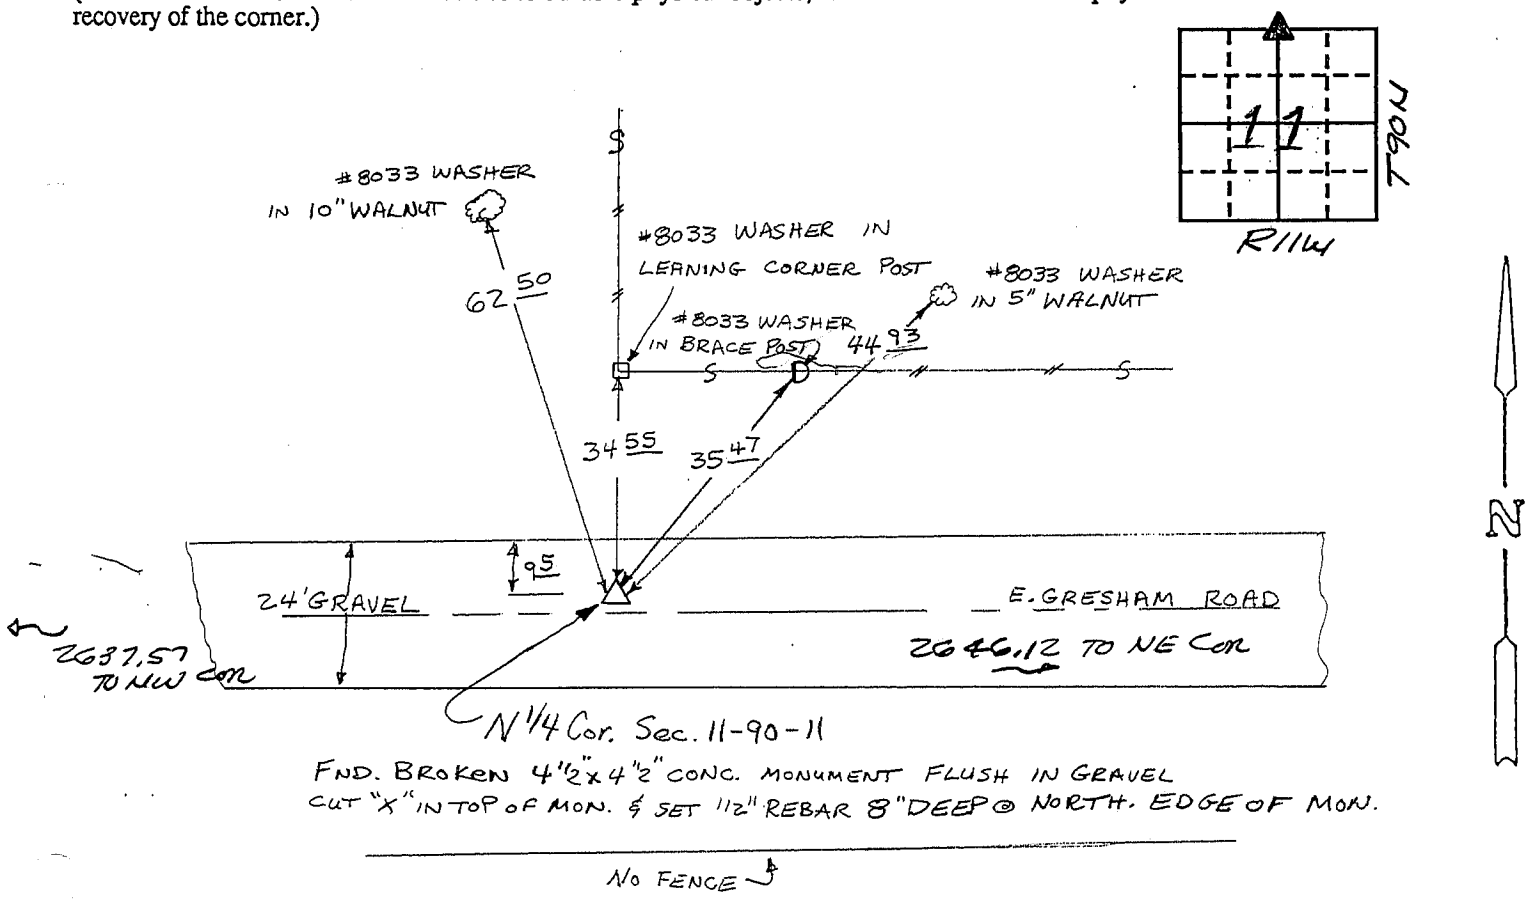

395-58

I hereby certify that the survey work was completed and this certificate was prepared by me or under my direct personal supervision and that I am a duly registered land surveyor under the laws of the state of Iowa.

Signature: F. William King
Name typed or printed: F. William King

Date: 1-25-1994 Reg. No. 8033

Corners	List Corners to be Indexed		
	Section	Twp	Range
N 1/4	11	90N	R11W

SEAL

WAYNE CLAASSEN ENGINEERING
AND SURVEYING, INC.
2709 UNIVERSITY AVE.
P.O. BOX 898
WATERLOO, IA 50704