



File 2018-00011235

United States Public Land Survey Corner Certificate

Section **11**, Township **90** North, Range **11** West of the Fifth Principal Meridian, **Black Hawk** County, Iowa.
On file in **Book 309, Page 781** in the County Recorder's office.

 $\{$


- ☐ There is no certificate on file for this corner.
☒ There are no longer three valid ties of record.
☐ There are changes to reference ties of record.
☐ There is change of monumentation of record.
☐ To clarify description of record monument (ties).

North 1/4 Corner: Found Mag Nail w/Stainless Steel Washer PLS 10793 in Concrete Monument with information obtained from the previously recorded Section Corner Certificate.

(Show a minimum of three reference ties to durable physical objects, relevant monuments and physical conditions that will enable recovery of the corner.)



A 4x4 grid with a solid arrow pointing up from the center cell, which contains the number 11.

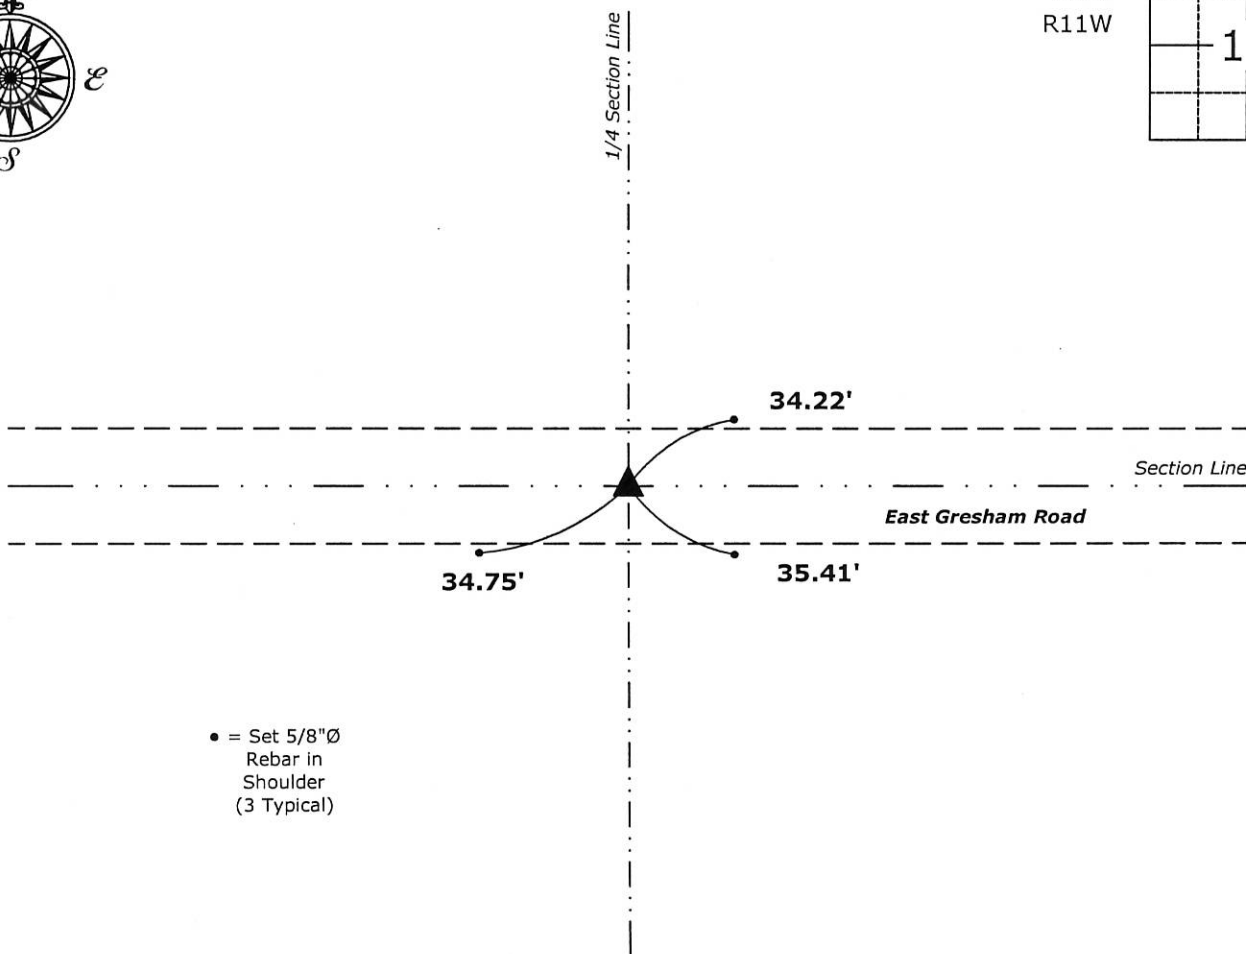

- = Set 5/8"Ø Rebar in Shoulder (3 Typical)

Found Mag Nail w/Stainless Steel Washer PLS 10793 in Concrete Monument



Date:

My license renewal date is December 31, 2017.
Sheets covered by this seal: Individual sheet only

Corner	Section	Twp.	Range
N 1/4	11	90	11

FB: Black Hawk 10, Pgs. 23-25