

Entered
5-2-94
BKS I & II

SLSI 9-90

UNITED STATES PUBLIC LAND SURVEY CORNER CERTIFICATE

OF


Land Survey Monuments situated in Section 11, Township T 90 N, Range 11 W, of the Fifth Principal Meridian, BLACK HAWK County, Iowa.
Previously recorded in N/A in County Recorder's Office.
(book, page, document number, etc.)

(Show reason for preparing this certificate, the evidence and detailed procedures used in establishing the corner positions and monumentation found or placed.)

Monument Description and Remarks: NW CORNER SEC. 11-90-11, FOUND NOTHING AT SITE,
POSSIBLE GRADED OUT IN 1950S. FOUND (1) OF WPA 1939 TIE POINTS (CUTS 21" Ø HICKORY)
SINCE DAMAGED BY LIGHTNING- NOW 28" Ø HICKORY, USED 1939 TIE TO HICKORY TREE ADJUSTED FOR
GROWTH, INTERSECTED WITH SPILT OF ROADWAY TO EAST.

PLAN - VIEW

(Show a minimum of three reference ties to durable physical objects, relevant monuments and physical conditions that will enable recovery of the corner.)

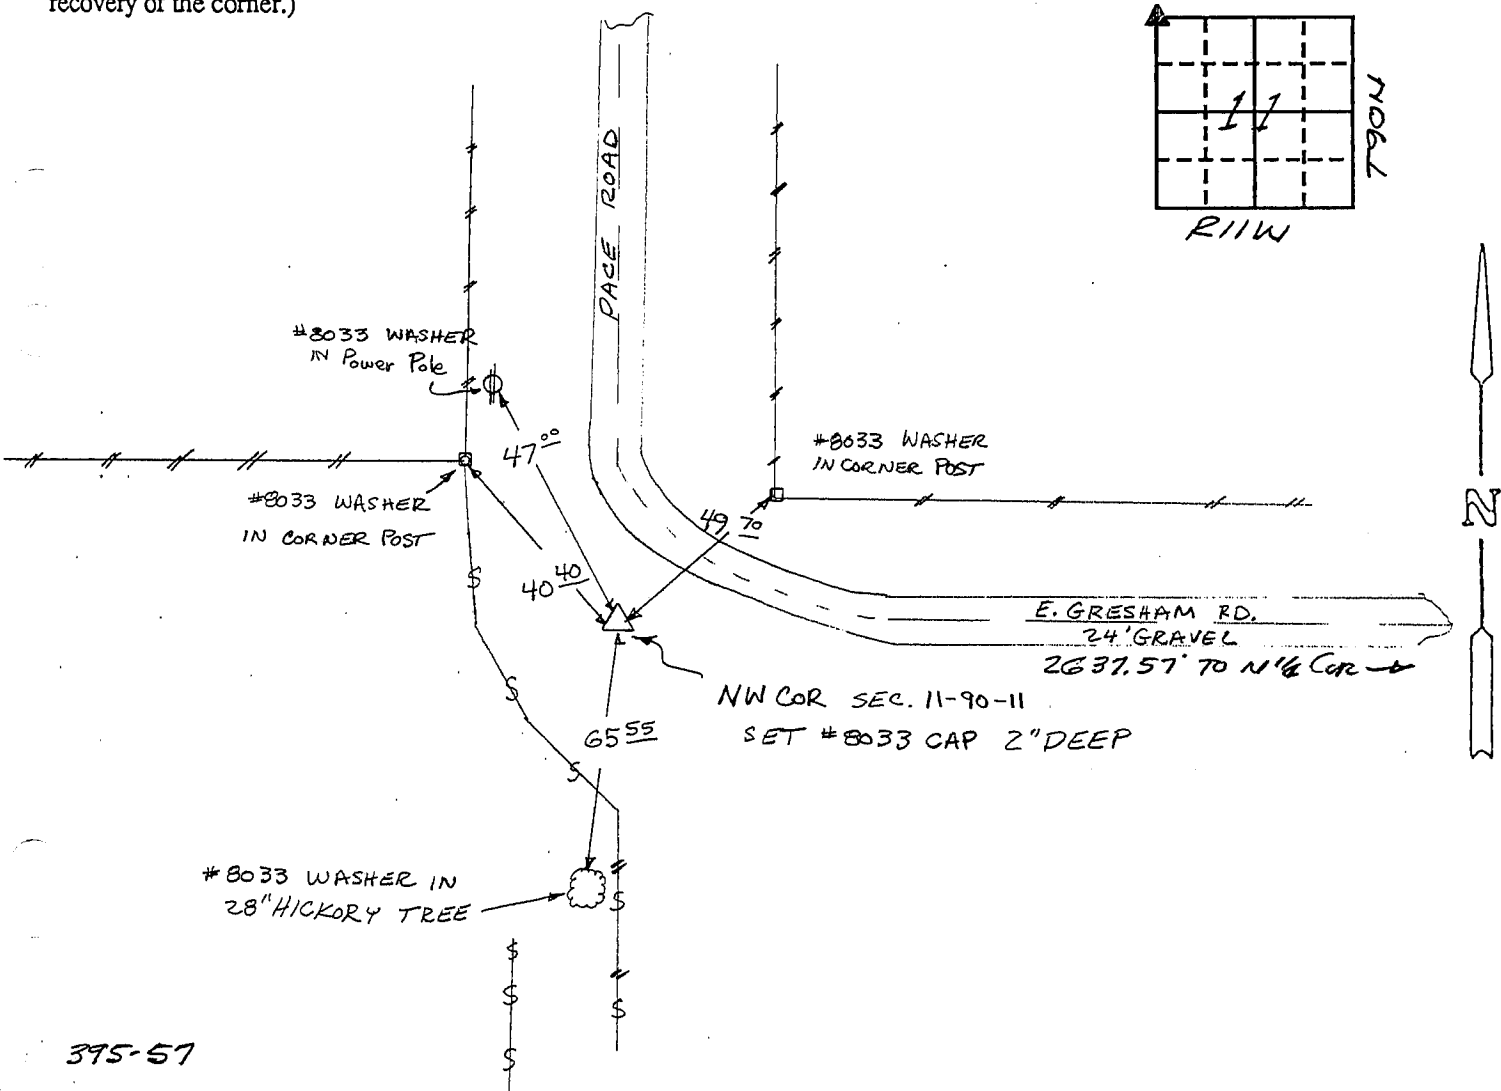

I hereby certify that the survey work was completed and this certificate was prepared by me or under my direct personal supervision and that I am a duly registered land surveyor under the laws of the state of Iowa.

Signature: F. William King

Name typed or printed: F. WILLIAM KING

Date: 1-25-1994 Reg. No. 8033

SEAL

Corners	List Corners to be Indexed		
	Section	Twp	Range
NW	11	90 N	11 W
NE	10		

WAYNE CLAASSEN ENGINEERING
AND SURVEYING, INC.
2709 UNIVERSITY AVE.
P.O. BOX 898
WATERLOO, IA 50704