

Kirk D. Eschliman, P.L.S. Iowa Lic. No. 9961, 723 Broadway Street, Waterloo, Iowa 50703 - Phone: 319-234-0509

UNITED STATES PUBLIC LAND SURVEY CORNER CERTIFICATE OF

LAND SURVEY MONUMENTS SITUATED IN SECTION THIRTEEN (13), TOWNSHIP NINETY (90) NORTH
RANGE ELEVEN (11) WEST, OF THE FIFTH PRINCIPAL MERIDIAN, BLACK HAWK COUNTY, IOWA.
PREVIOUSLY RECORDED IN BUCHANAN CO. DOC. 2007R00314 (BOOK, PAGE, DOCUMENT NUMBER, ETC.) IN THE COUNTY RECORDER'S OFFICE.

(SHOW REASON FOR PREPARING THIS CERTIFICATE, THE EVIDENCE AND DETAILED PROCEDURES USED IN ESTABLISHING THE CORNER POSITIONS AND MONUMENTATION FOUND OR PLACED.)


MONUMENT DESCRIPTION AND REMARKS:

FOUND 5/8" EPOXY REBAR 5 INCHES BELOW GRANULAR SURFACE ALONG EAST SIDE OF SCM WITH BRASS CAP.

FOUND CONCRETE MONUMENT 18 INCHES BELOW GRANULAR SURFACE. DROVE EPOXY REBAR BELOW TOP OF

MONUMENT. SET 5/8" REBAR WITH 2" ALUMINUM CAP, 2 INCHES BELOW GRANULAR SURFACE, DIRECTLY ABOVE

CONCRETE MONUMENT. MONUMENT USED IN REFERENCED FIELD SURVEY IN NW 1/4 OF SECTION 18.

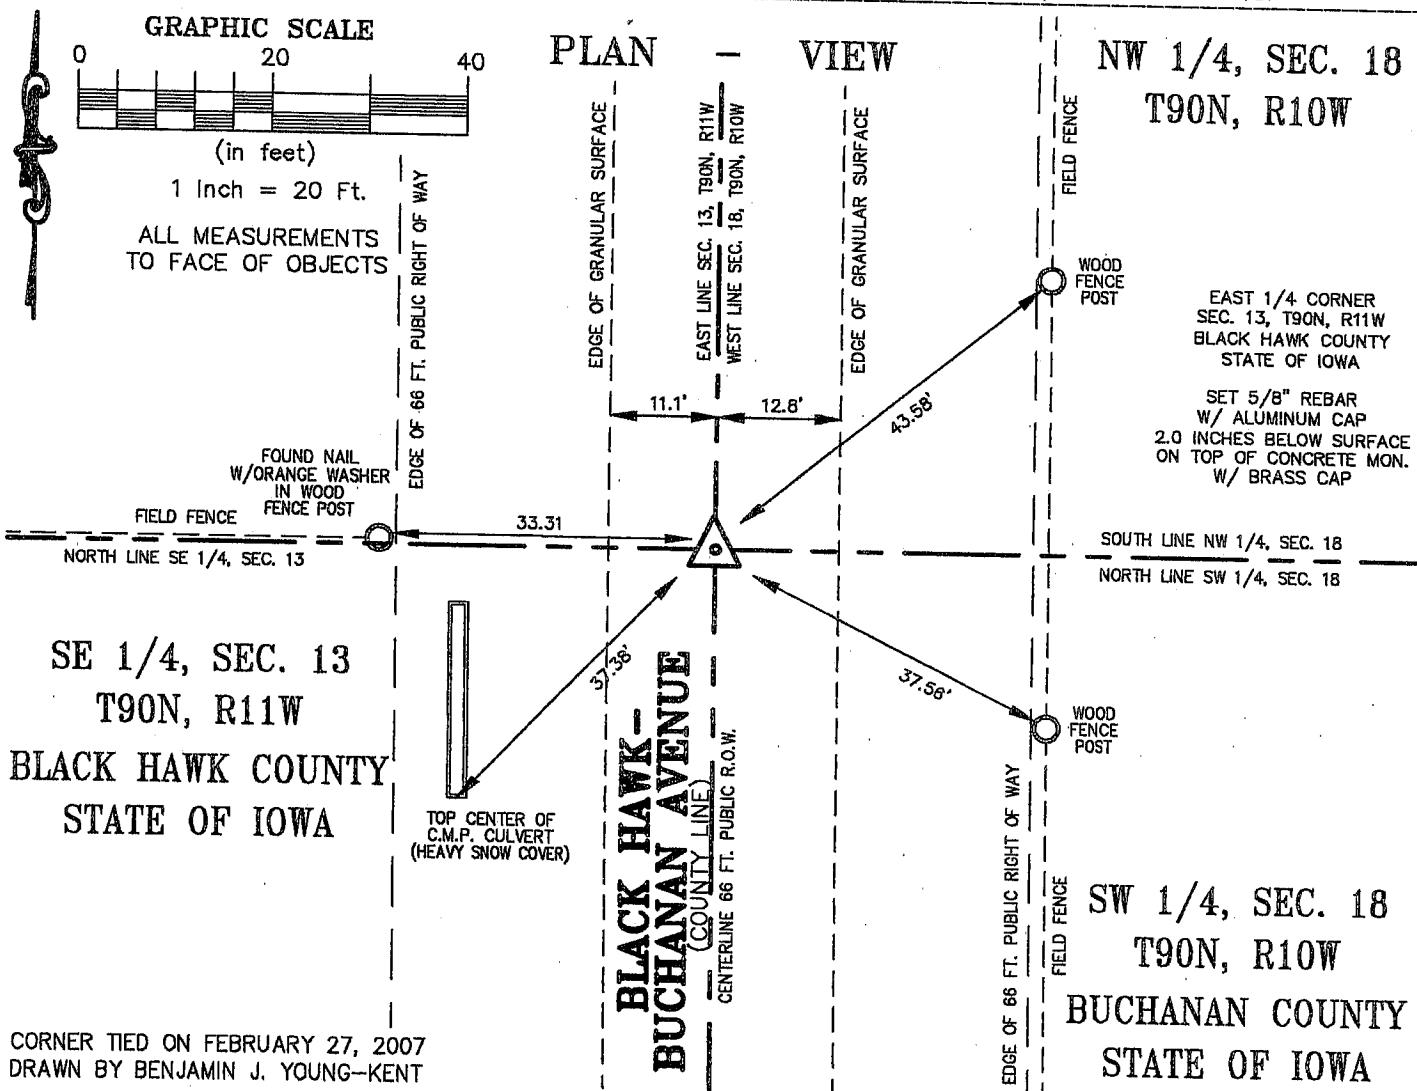

I HEREBY CERTIFY THAT THIS LAND SURVEYING DOCUMENT WAS PREPARED AND RELATED SURVEY WORK WAS PERFORMED BY ME OR UNDER MY DIRECT PERSONAL SUPERVISION AND THAT I AM A DULY LICENSED LAND SURVEYOR UNDER THE LAWS OF THE STATE OF IOWA.

Kirk D. Eschliman DATE: 02/28/2007

KIRK D. ESCHLIMAN, P.L.S. IOWA LIC. NO. 9961
MY LICENSE RENEWAL DATE IS DECEMBER 31, 2007
PAGES OR SHEETS COVERED BY THIS SIGNATURE & SEAL: SHEET 1 OF 1

FOR: TIM & JULIE JOYCE
1224 BLACK HAWK-BUCHANAN AVENUE
FAIRBANK, IOWA 50629


REQ. BY: TIM JOYCE
FAIRBANK, IOWA 50629



KESS & ASSOCIATES, INC.
PROFESSIONAL LAND SURVEYORS: 723 BROADWAY, WATERLOO, IOWA 50703-5811
DATE: 02/28/2007 C.A.D.D. FILE: 07A19SCC1BH.DWG PROJECT NO.: 07A19

List of corners to be indexed:

Corner	Section	Township	Range
E 1/4	13	T90N	R11W

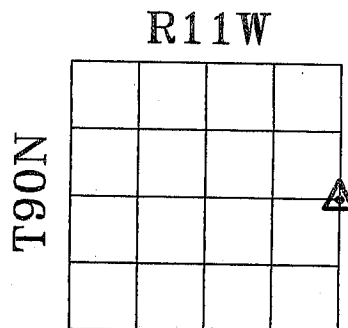

SECTION 13