

REC FEE 5⁰⁰
E FEE 2⁰⁰
TRAN FEE _____
REV FEE _____
GF 7⁰⁰

Doc ID: 005633870001 Type: GEN
Recorded: 12/05/2014 at 08:50:25 AM
Fee Amt: \$7.00 Page 1 of 1
Black Hawk County Iowa
JUDITH A MCCARTHY RECORDER
File **2015-00009420**

Prepared by & Return to: Herold - Reicks Surveying, 10 East Main Street, New Hampton, IA 50659, Ph. 641-394-2725

UNITED STATES PUBLIC LAND SURVEY CORNER CERTIFICATE

Land Survey Monuments situated in Section **13**, Township **90** North, Range **11** West of the Fifth Principal Meridian, **Black Hawk** County, Iowa. Not previously recorded in the County Recorder's office.

This certificate is being prepared in compliance with Iowa Code Chapter 355.11 because:


- ☐ There is no certificate on file for this corner.
☐ There are no longer three valid ties of record.
☐ There are changes to reference ties of record.
☒ There is change of monumentation of record.
☐ To clarify description of record monument (ties).

Monument Description and Remarks:

Southeast Corner: Fd. bent 1/2"Ø Rebar with information obtained from previous a Section Corner Certificate, recorded in Book 1, Page 3, on file in the Buchanan County Recorder's office, Independence, Iowa. Removed damaged monument and replaced with 5/8"Ø Rebar w/2"Ø Alum. Cap PLS 15525.

PLAN - VIEW

(Show a minimum of three reference ties to durable physical objects, relevant monuments and physical conditions that will enable recovery of the corner.)

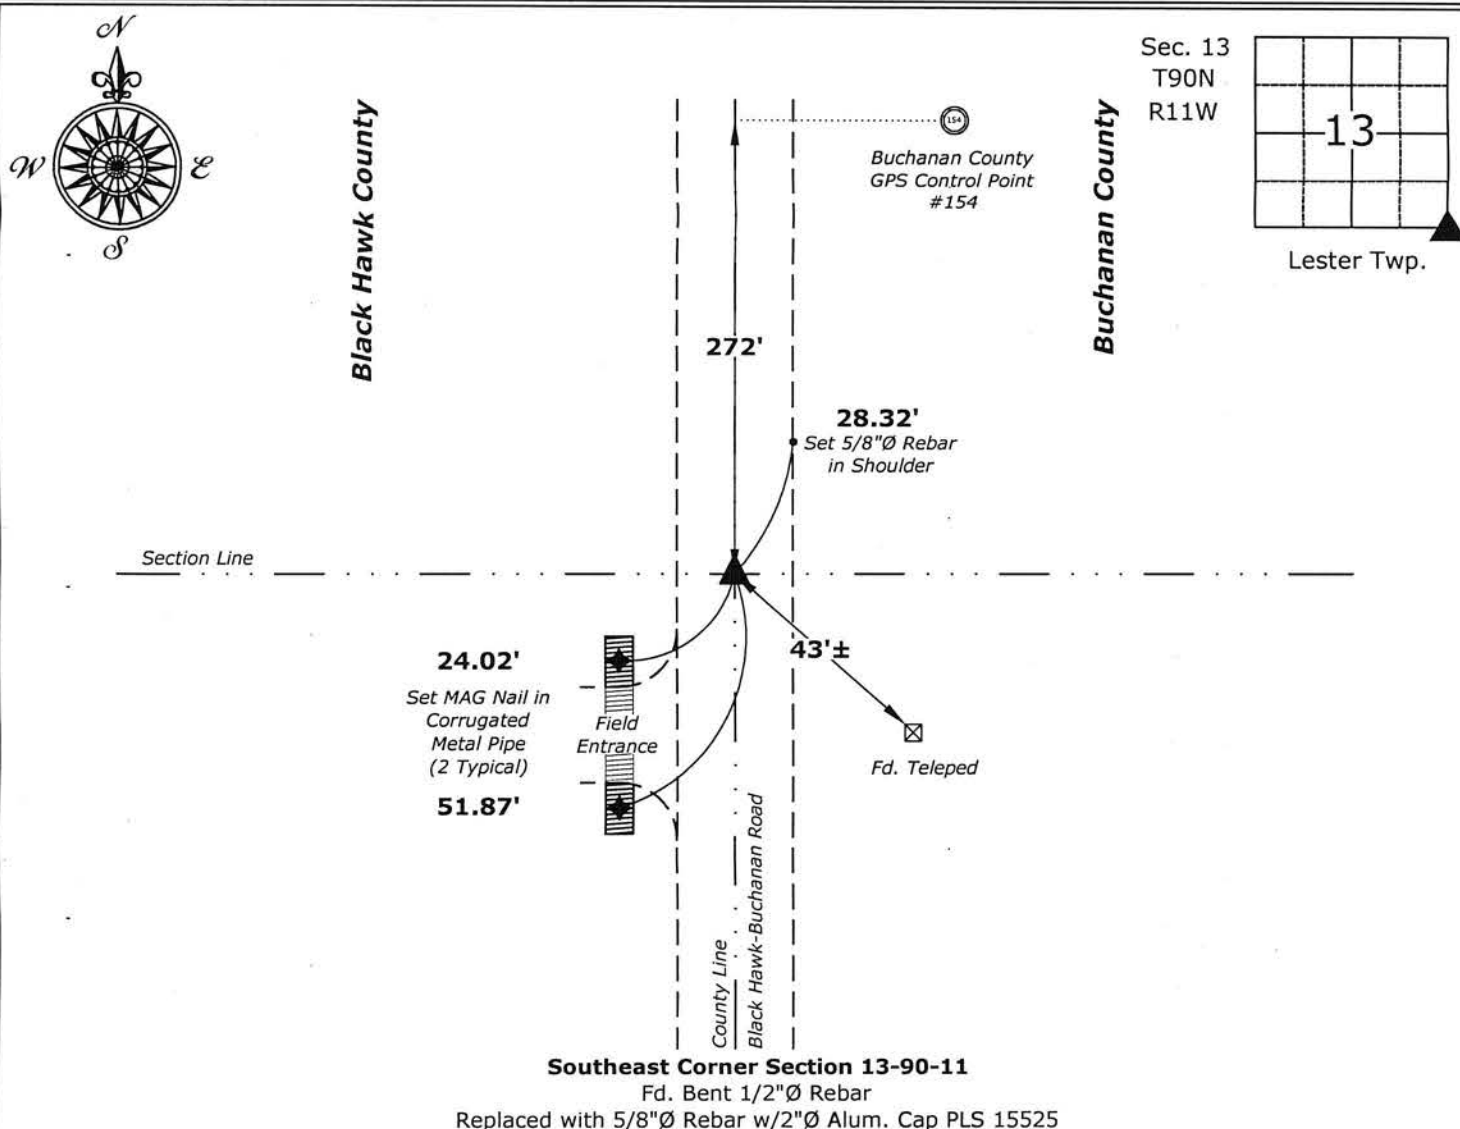

I hereby certify that this land surveying document was prepared and the related survey work was performed by me or under my direct personal supervision and that I am a duly licensed Land Surveyor under the laws of the State of Iowa.

Paul R. Herold 12-4-14

Paul R. Herold

Date:

License number 15525

My license renewal date is December 31, 2014.

Sheets covered by this seal: Individual sheet only

List Corners to be Indexed

Corners	Section	Twp.	Range
SE	13	90	11

Project Number: 2014-167

FB: Buchanan County 1, Pgs. 14-15